


T.39S.,R.8W.,W.M.

RECEIVED

DEC 13 1974

WM. DIST. 14  
GRANTS PASS, ORE.

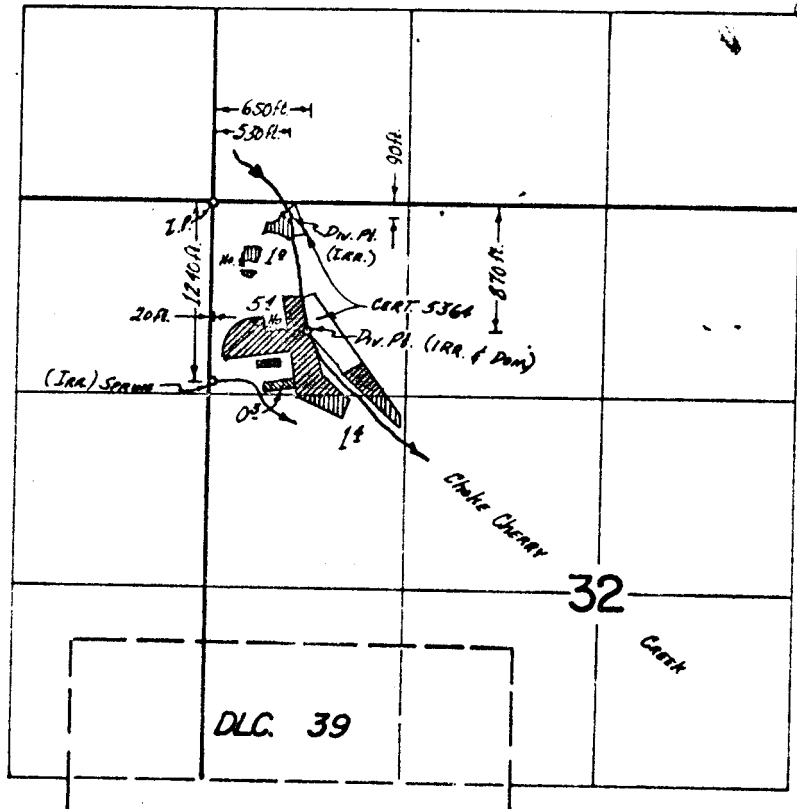

# FINAL PROOF SURVEY

UNDER

41059  
41399  
43568



30721  
30924  
32984

Application No. ....

Permit No. ....

IN NAME OF

JOE L. BLESER

Surveyed 3 Nov. 1972, by L. E. GORUP