


T.39S.,R.8W.,W.M.

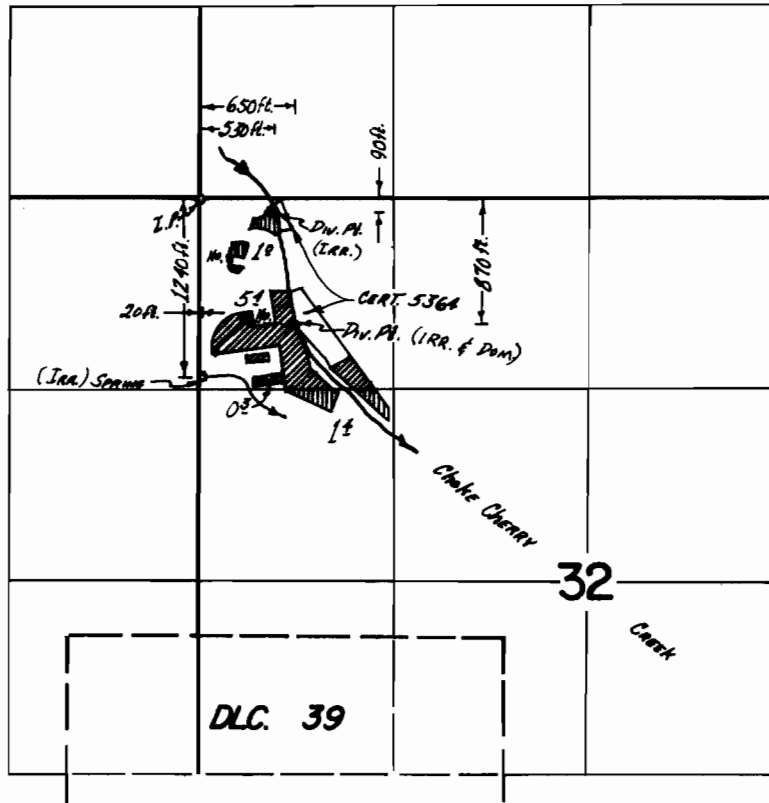

FINAL PROOF SURVEY
UNDER

41059
41399
43568



30721
30924
32984

Application No. Permit No.

IN NAME OF

JOE L. BLESER

Surveyed 3 Nov. 1972, by L.E. GOULD