


T.39S.,R.8W.,W.M.

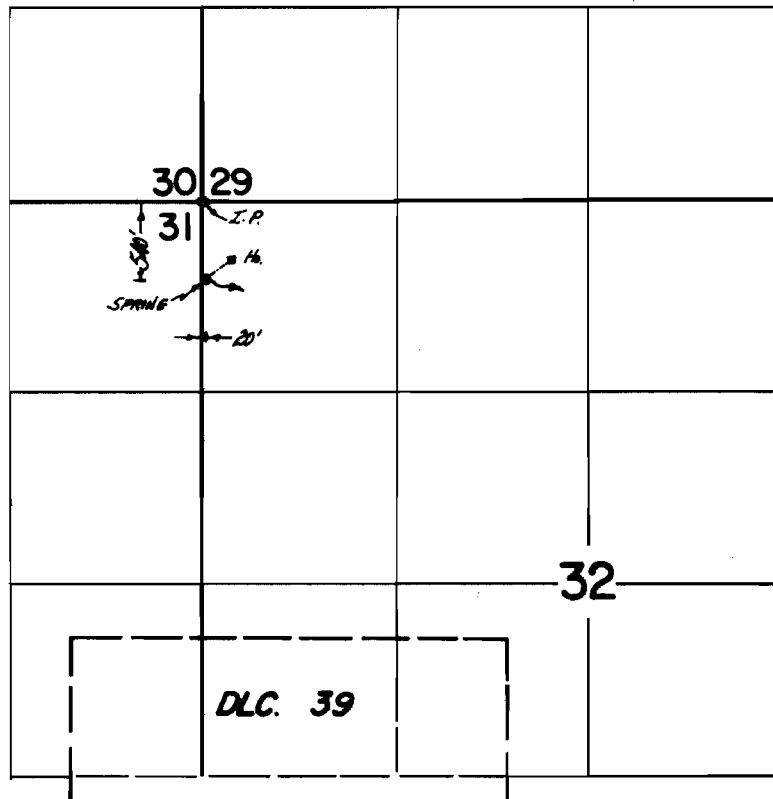

FINAL PROOF SURVEY
UNDER

Application No. 41465 Permit No. 30958
IN NAME OF

EDWARD A. & THERESIA M. MORAN

Surveyed 1 Nov. 1972, by L.E. GOULD