


# T. 34S. R. 6W. W.M.

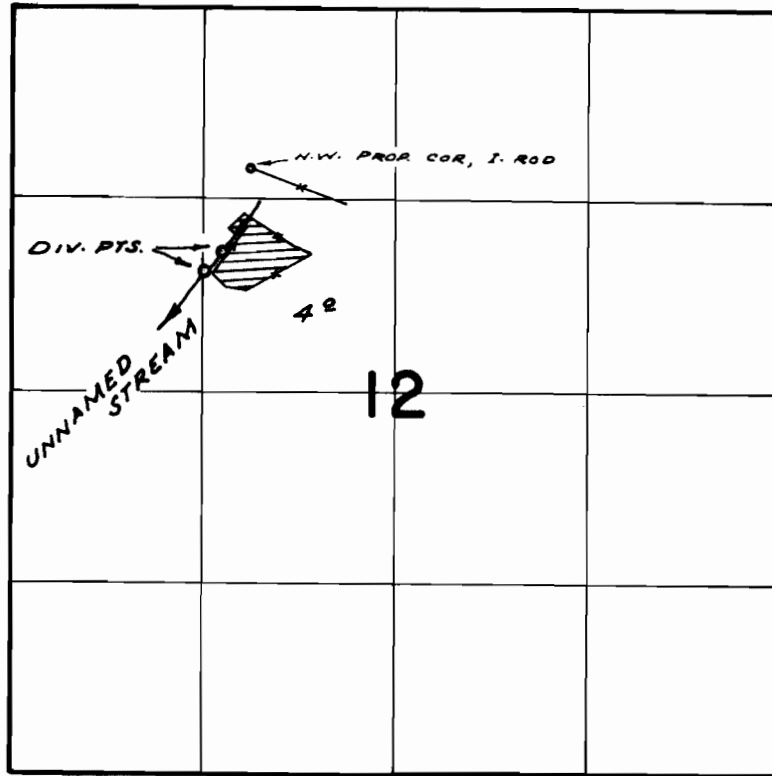

DIV. PTS. LOC: 1680'S. & 1180'W ; 1810'S. & 1310'W, BOTH FROM N $\frac{1}{2}$  COR. SEC. 12

## FINAL PROOF SURVEY UNDER

Application No. 42464 Permit No. 31760  
IN NAME OF

.....ANN L. SLOAN.....

Surveyed APR. 12, 1972, by R. MUCKEN