


T. 35S. R. 7W. W.M.

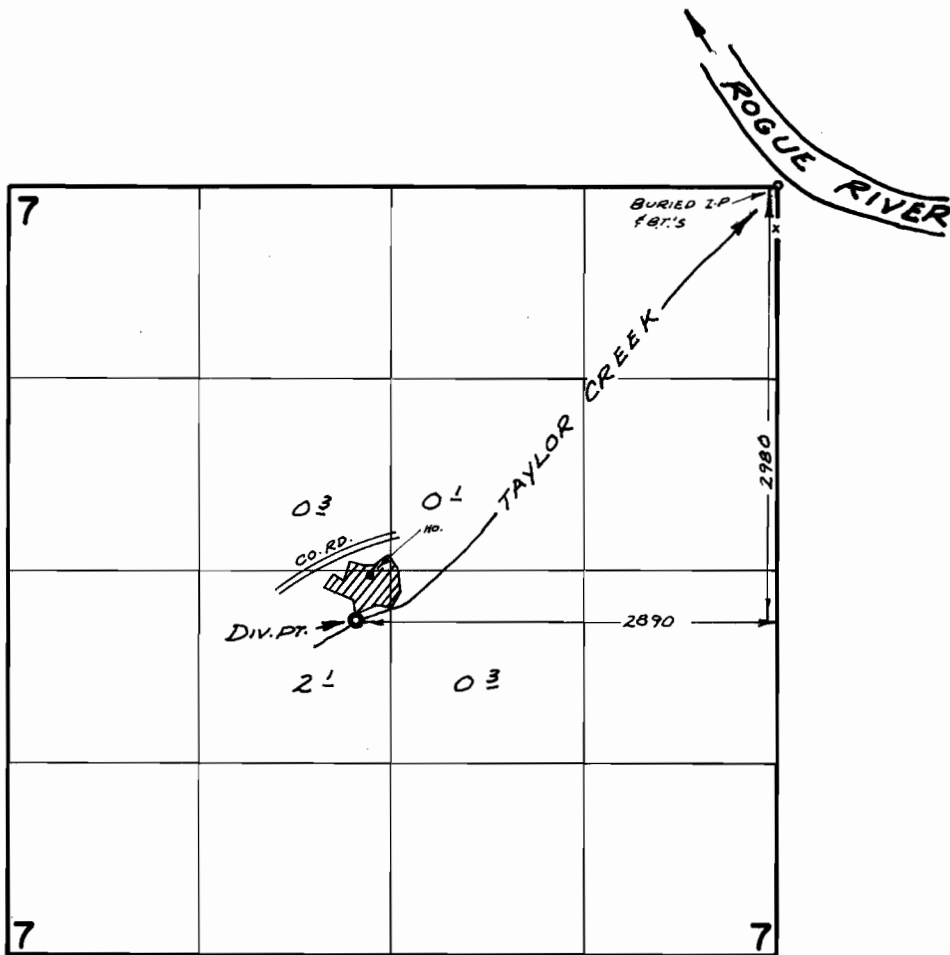

**FINAL PROOF SURVEY**  
UNDER

Application No. 42938 Permit No. 32082  
IN NAME OF

HOWARD G. MORNING

Surveyed APR. 17, 1972, by R. MUCKEN