


T.36S.R.7W.W.M.

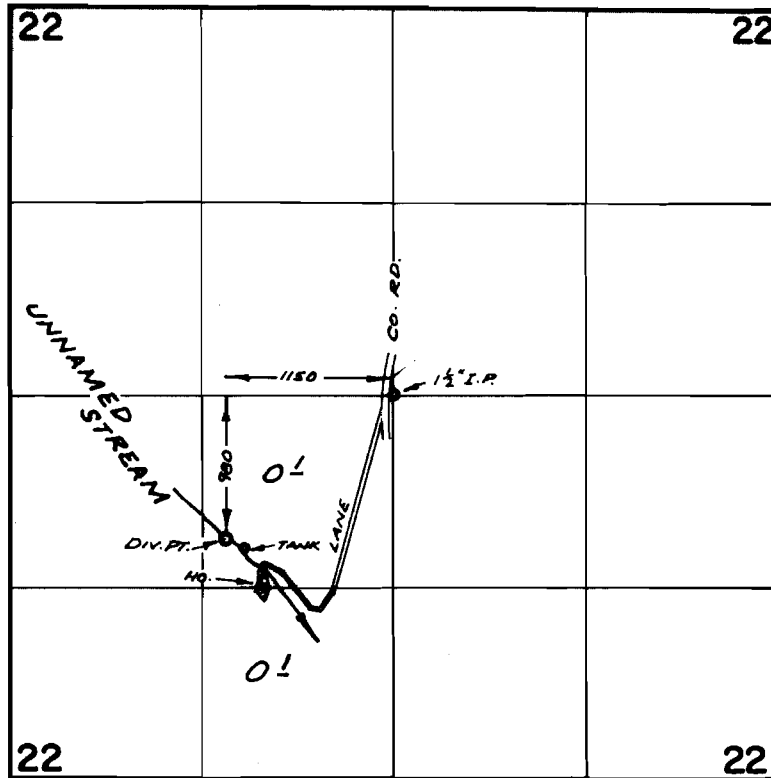

FINAL PROOF SURVEY
UNDER

Application No. 44101 Permit No. 32945
IN NAME OF

STEVEN A. MC SHANE

Surveyed APR. 21, 1972. by R. MUSKEN