


T.39S.,R.8W.,W.M.

RECEIVED

DEC 13 1974

WM. DIST. 14
GRANTS PASS, ORE.

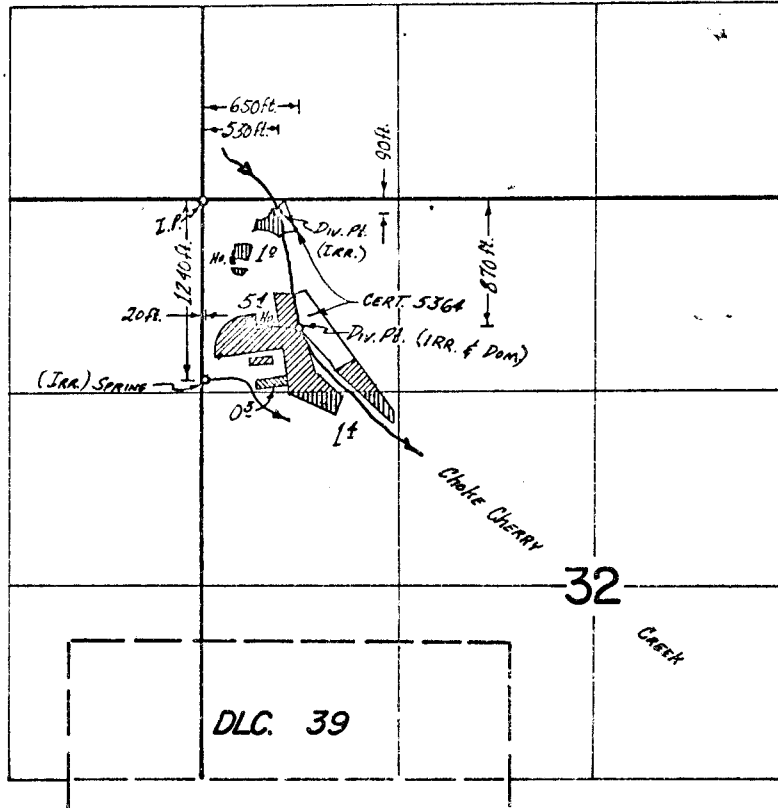

FINAL PROOF SURVEY

UNDER

| | | |
|-------|---|-------|
| 41059 | ▨ | 30721 |
| 41399 | ▨ | 30924 |
| 43568 | ▨ | 32984 |

Application No. Permit No.

IN NAME OF

.....
JOE L. BLESER
.....

Surveyed 3 Nov. 1972, by L.E. GOULD