


T.35S.R.7W.W.M.

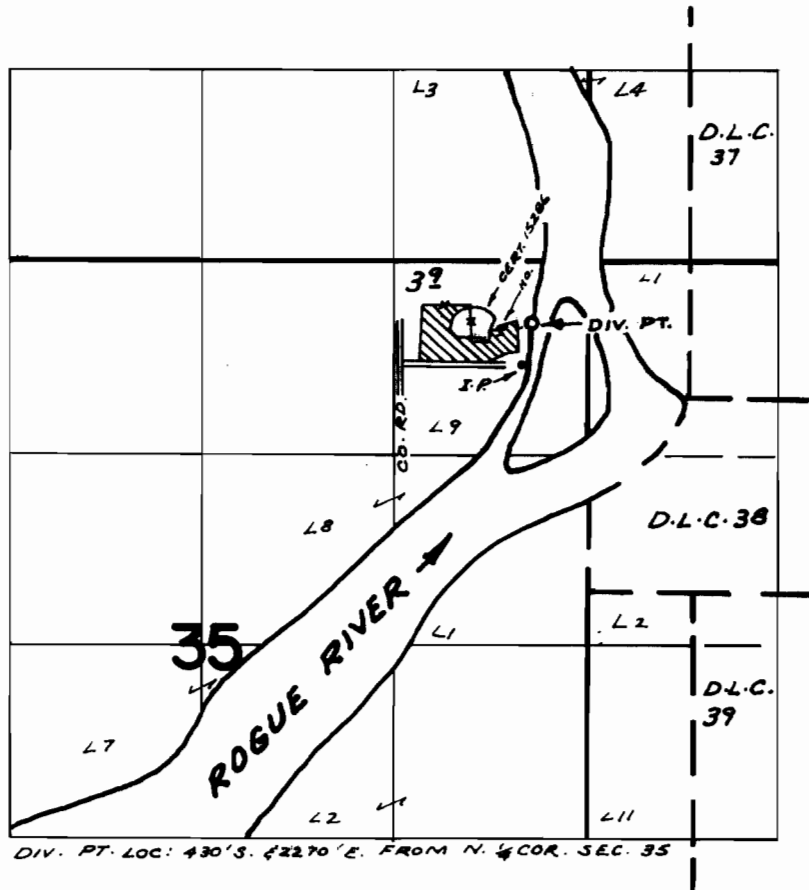

**FINAL PROOF SURVEY**  
UNDER

Application No. 44953 Permit No. 33114  
IN NAME OF

WESLEY E. & BETTY L. HOXENG

Surveyed APR. 18, 1972, by R. MUCKEN