


T.34 S.R.6W.W.M.

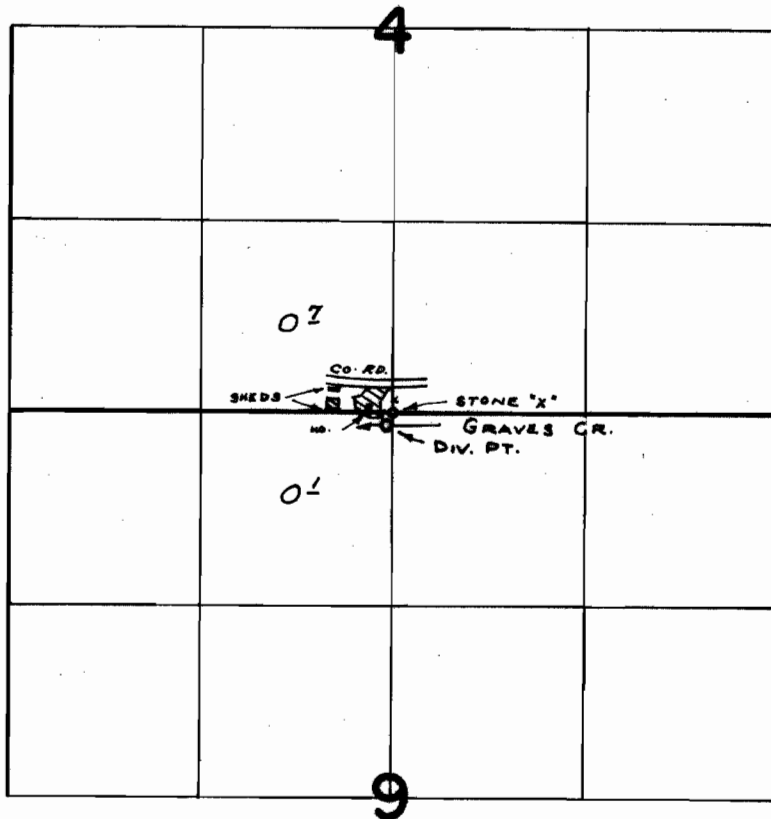

DIV. PT. LOC: 80'S. & 40'W. FROM N $\frac{1}{4}$ COR. SEC. 9

FINAL PROOF SURVEY UNDER

Application No. 44854 Permit No. 33541
IN NAME OF

ROBERT A. SNORK

Surveyed APR. 12 1972, by R. MUCKEN