


T.38 S., R.7&8 W., W.M.

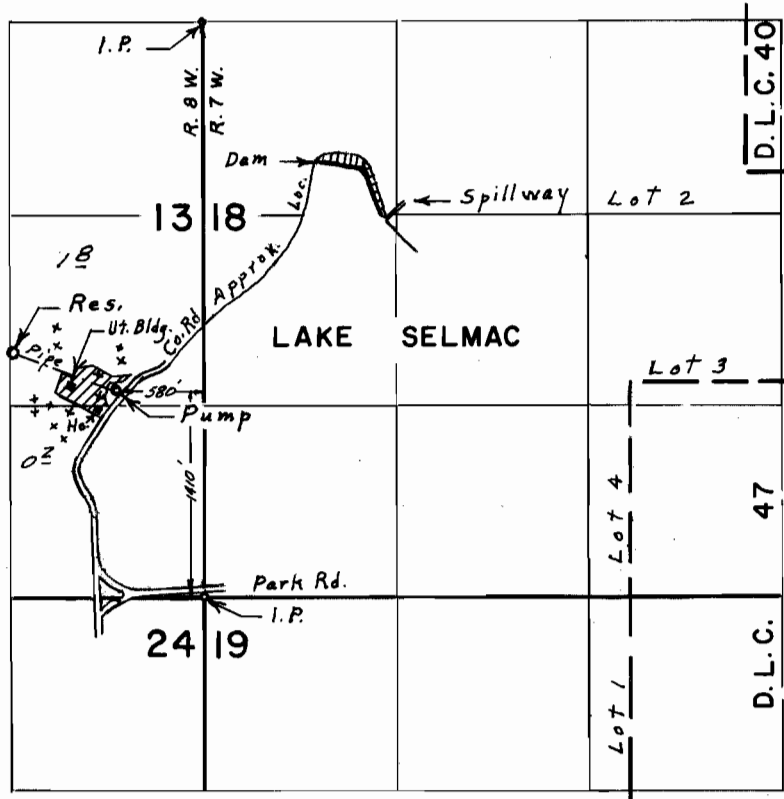

FINAL PROOF SURVEY
UNDER

R-46777 R-5552
 42994 34734
 Application No. R-40813 Permit No. R-4557
 IN NAME OF

JOSEPHINE COUNTY

Surveyed Oct. 25, 1972, by L. E. Gould.