


T. 11 S. R. 1 W. W.M.

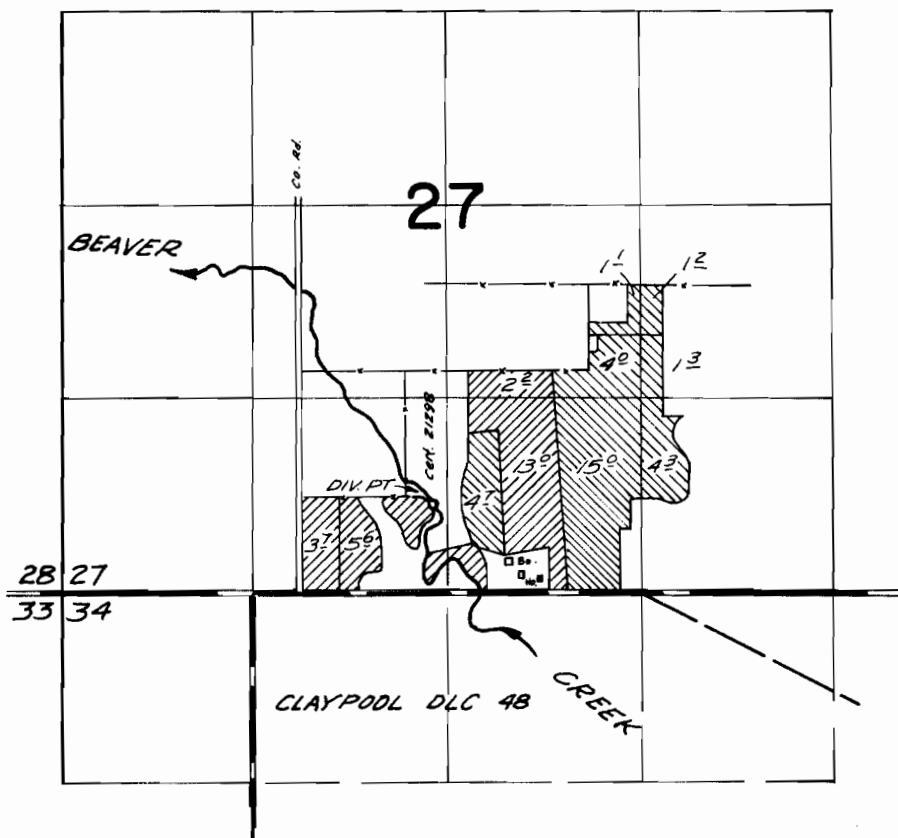

Div. Pt. located 610 ft. N. of 1240 ft. E. from the NW. cor. of Claypool DLC. 48

 Permit 31980
 Permit 35956

FINAL PROOF SURVEY UNDER

Application No. 42774 48002 Permit No. 31980 35956
 IN NAME OF

VICTOR E. & FRANCIS G. CHRISTENSEN

Surveyed July 25 1973, by L.E. Gould