


T.6S. R.1W. W.M.

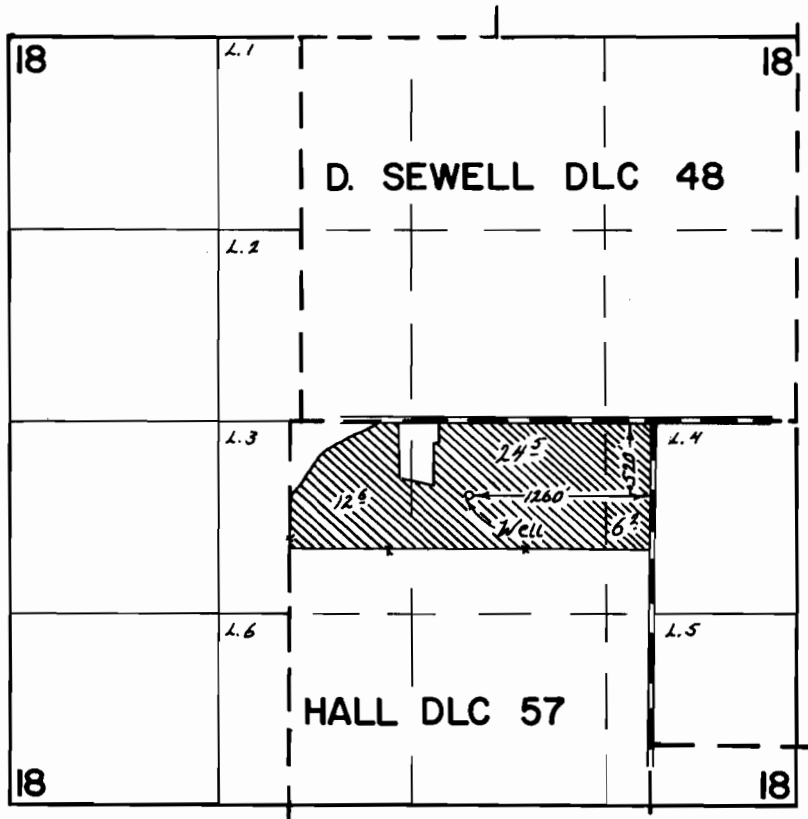

FINAL PROOF SURVEY
UNDER

Application No. G-3332 Permit No. G-3052
IN NAME OF

BOB K. COMBS

Surveyed June 2, 1972, by R. G. Mucken