


# T. 5 S. R. 1 & 2 W. W.M.

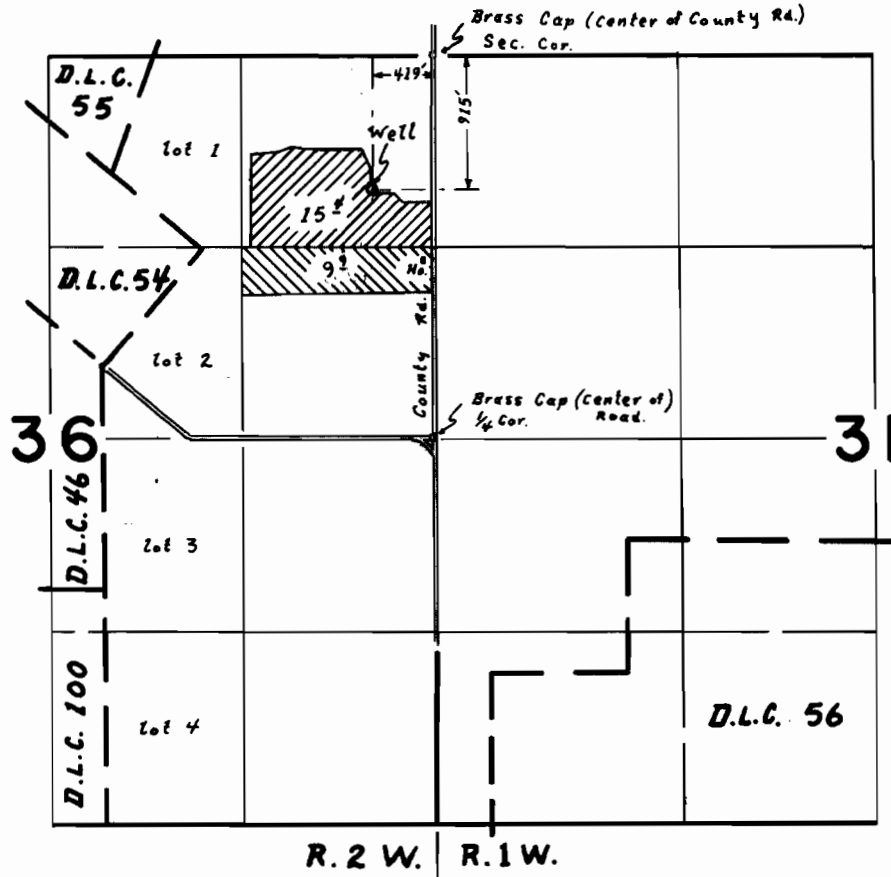

## FINAL PROOF SURVEY UNDER

Application No. G-3337 Permit No. G-3133  
IN NAME OF

Cyril Moullet

Surveyed 10 OCT 1972 by D. O'Reilly