


# T. 5 S. R. 2 W. W.M.

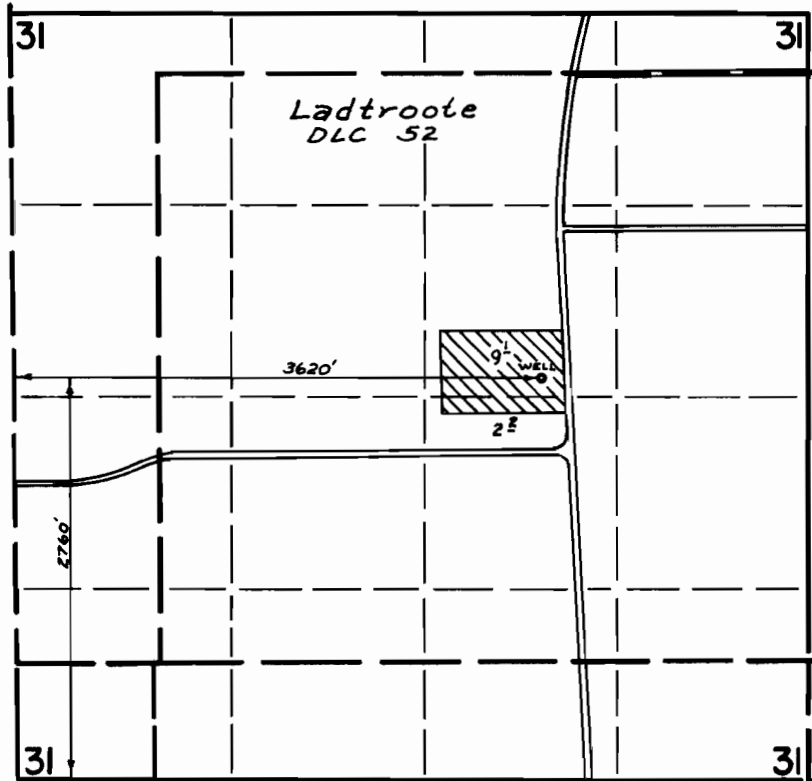

## FINAL PROOF SURVEY UNDER

Application No. G-3849 Permit No. G-3625  
IN NAME OF

NICOLAS GARCIA

Surveyed Sept 22 1972, by D. Norby