


T. 7 S. R. 2 W. W.M.

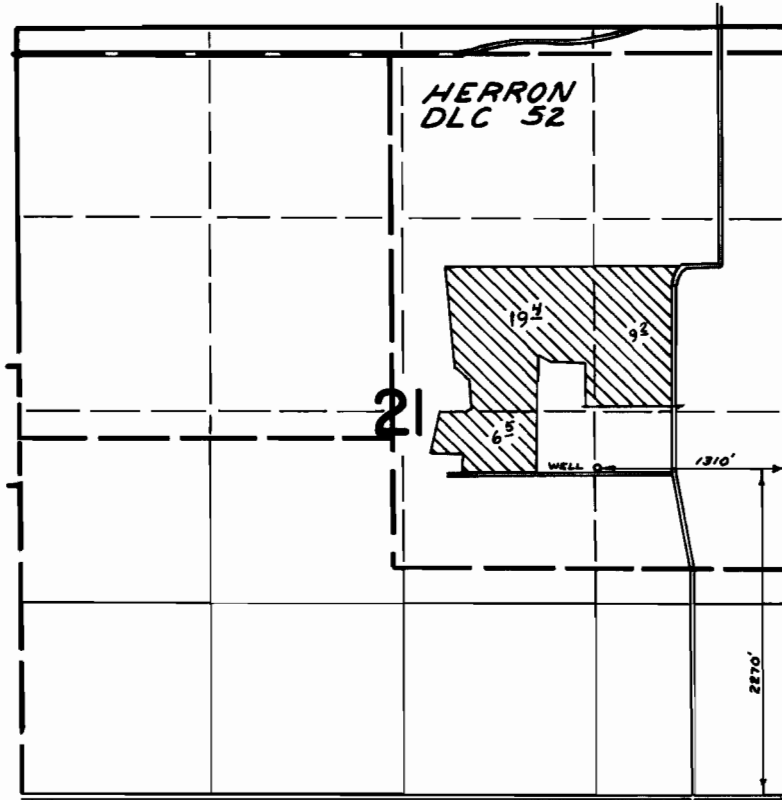

FINAL PROOF SURVEY
UNDER

Application No. G-3854 Permit No. G-3630
IN NAME OF

ROBERT FORDYCE

Surveyed April 28 1972, by D. Norby