


T. 5 S. R. 2 W. W.M.

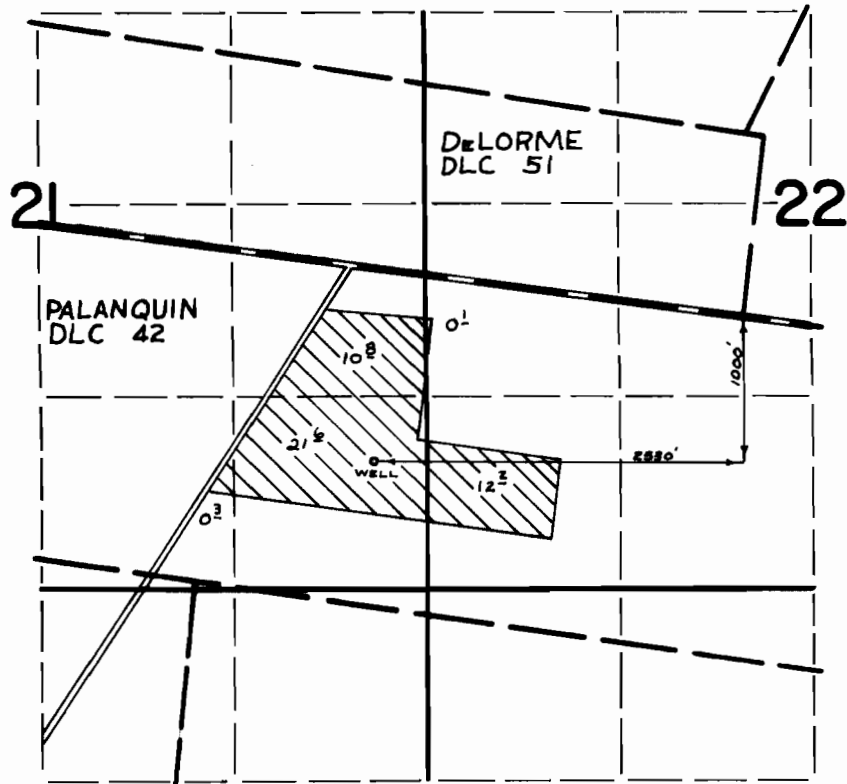

FINAL PROOF SURVEY
UNDER

Application No. G-3924 Permit No. G-3722
IN NAME OF

JOSEPH W. TESCH

Surveyed Sept. 27, 1972, by D. Norby