


T.6S. R.1W. W.M.

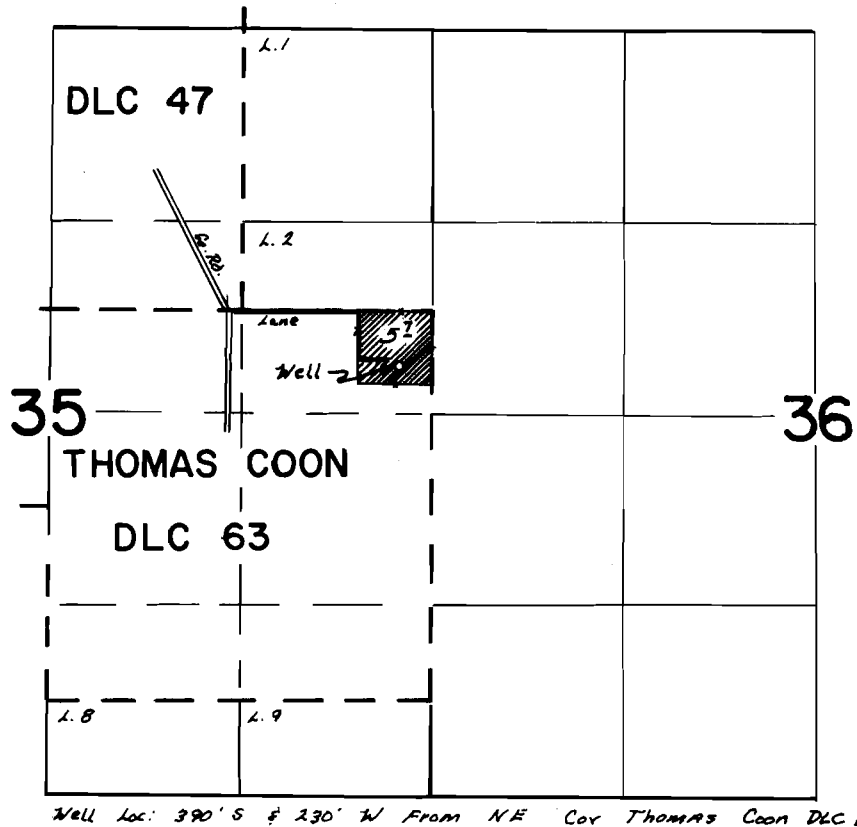

FINAL PROOF SURVEY UNDER

Application No. C-4129 Permit No. B-3879
IN NAME OF

PETER P & GENEVIE D. GERHARDS

Surveyed July 28 1972, by R. D. Mucken