


# T.6S. R.2W. W.M.

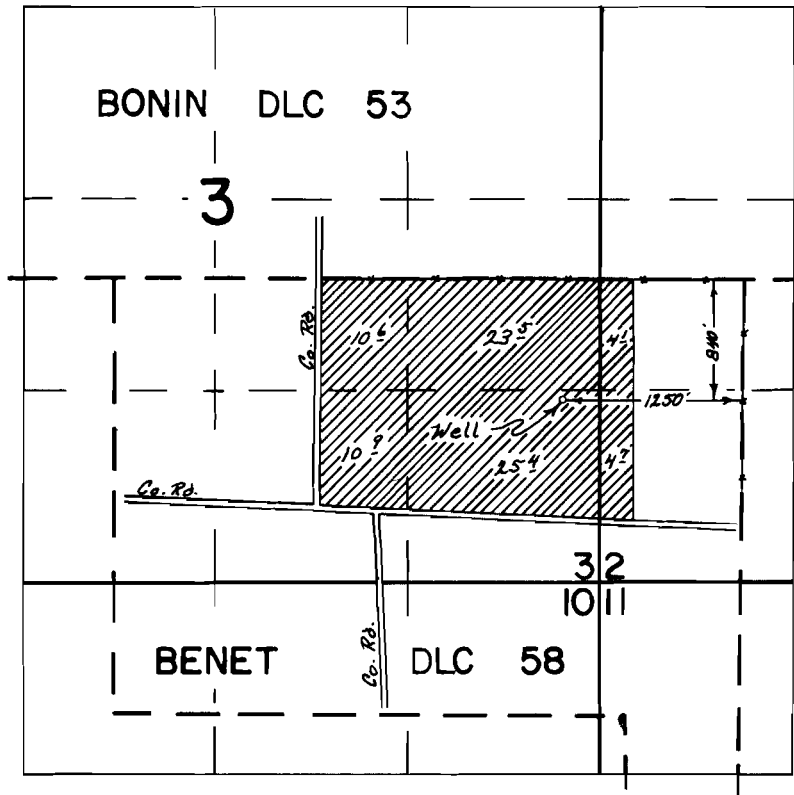

## FINAL PROOF SURVEY UNDER

Application No. 6-4193 Permit No. 6-3958  
IN NAME OF

JAMES HOLLIN

Surveyed May 18 1972, by R. B. Mucker