


T.6S. R.2W. W.M.

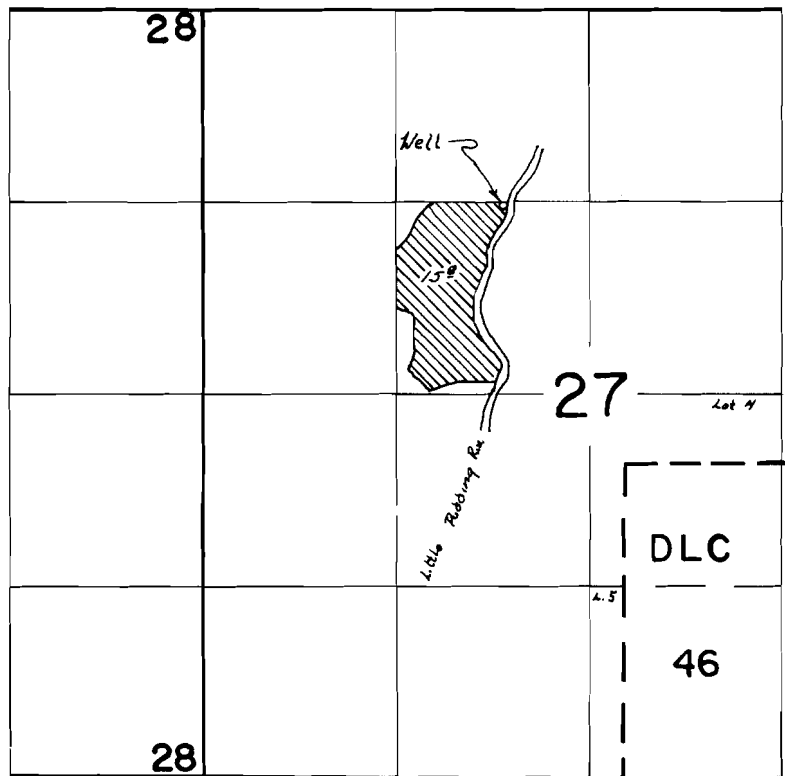

Well Loc: 20's & 740' E From NW Cor SE 1/4 NW 1/4 SEC 27

FINAL PROOF SURVEY
UNDER

Application No. B-4214 Permit No. B-3978
IN NAME OF

BENNETT & PORTER

Surveyed April 7, 1972, by R. B. Mucken