


# T.6S. R.1W. W.M.

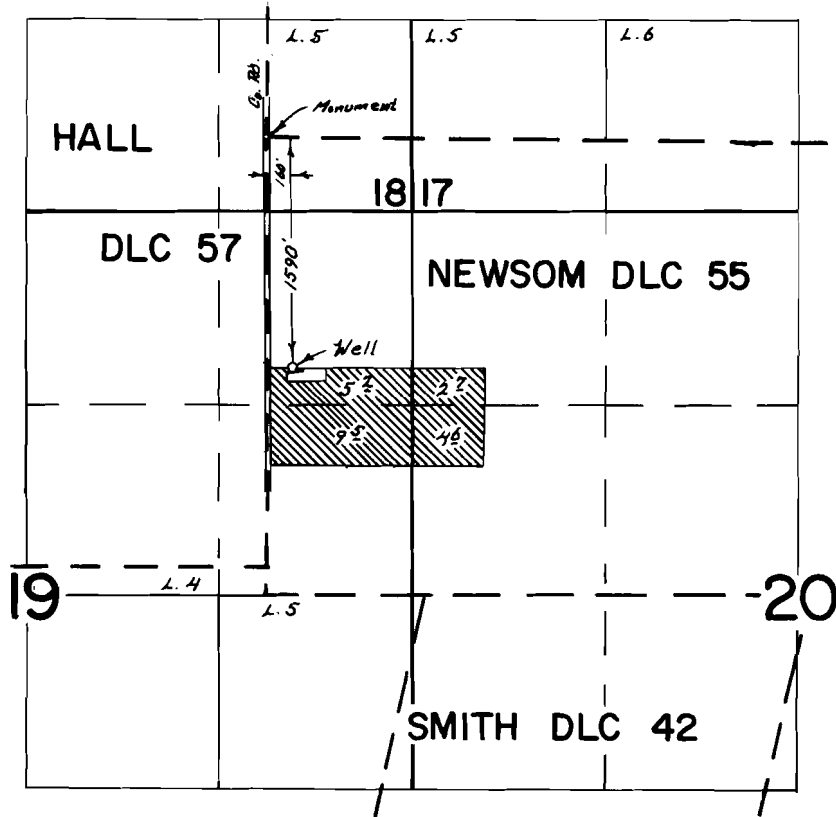

## FINAL PROOF SURVEY UNDER

Application No. G-4310 Permit No. G-4070  
IN NAME OF

NORBERT EDER

Surveyed June 1 1972, by R. G. Mucken