


T.6S. R.2W. W.M.

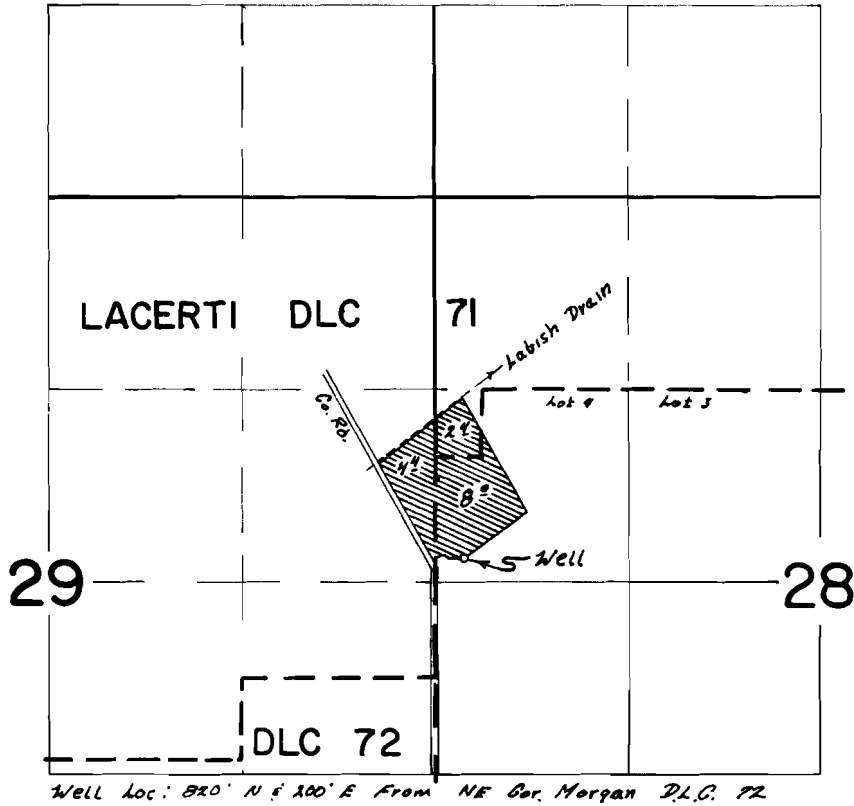

**FINAL PROOF SURVEY**  
UNDER

Application No. C-4347 Permit No. R-4104  
IN NAME OF

G. C. GUZMAN

Surveyed April 4, 1972, by R. G. Mucken