


# T.6S. R.1&2W. W.M.

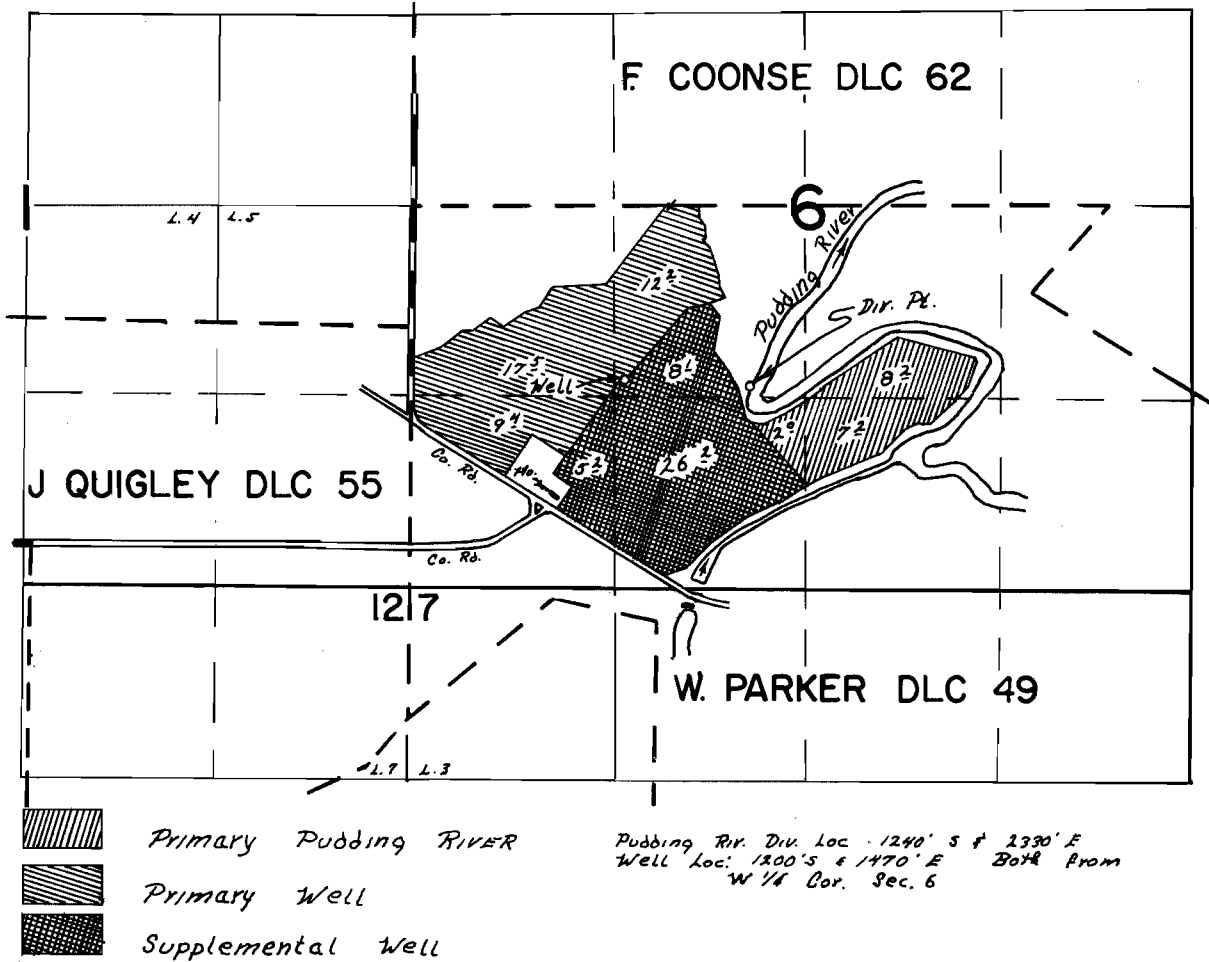

## FINAL PROOF SURVEY UNDER

Application No. G-4495 Permit No. B-4237  
44438 33243  
 IN NAME OF

JOE DANIELS

Surveyed July 5 1972, by R. G. Mucken