


T.6S. R.2W. W.M.

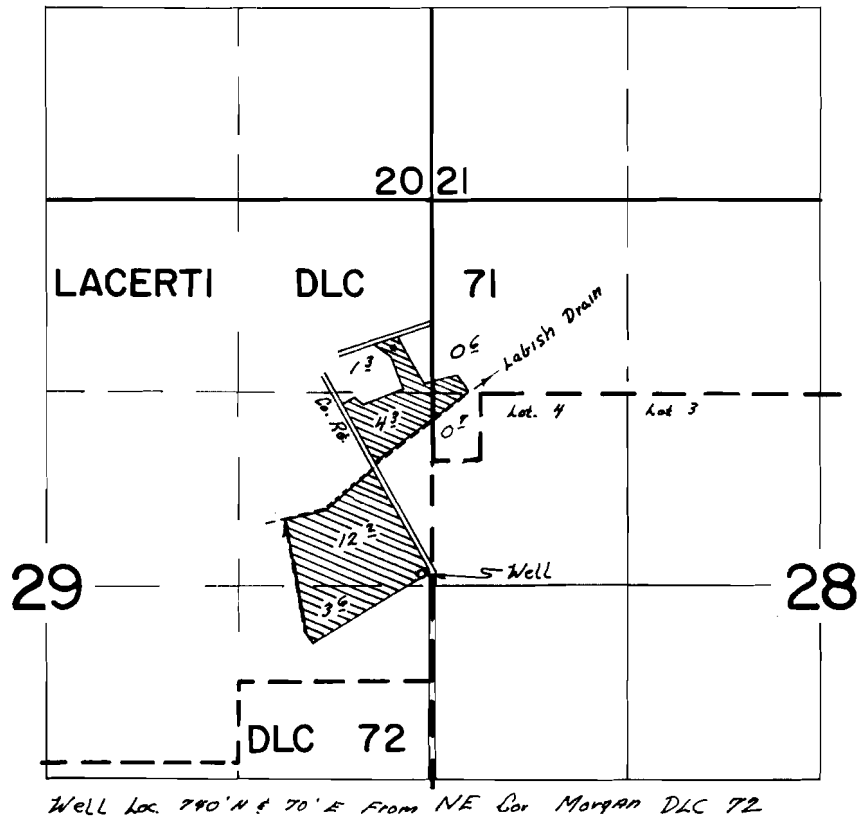

FINAL PROOF SURVEY
UNDER

Application No. B-4517 Permit No. B-4256
IN NAME OF

HARVEY L. LEA

Surveyed April 4, 1972, by R. G. Mucken