


T. 6S. R. 2W. W.M

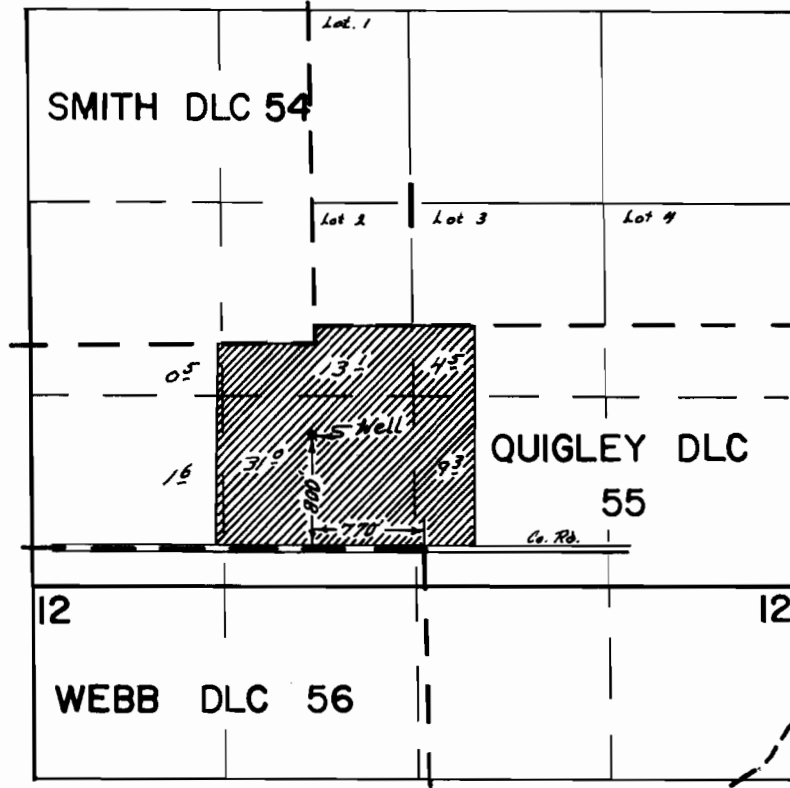

FINAL PROOF SURVEY
UNDER

Application No. B-4581 Permit No. C-4285
IN NAME OF

PETER J. MILLER

Surveyed May 16 1972, by R. B. Mucken