


T.5S. R.2W. W.M.

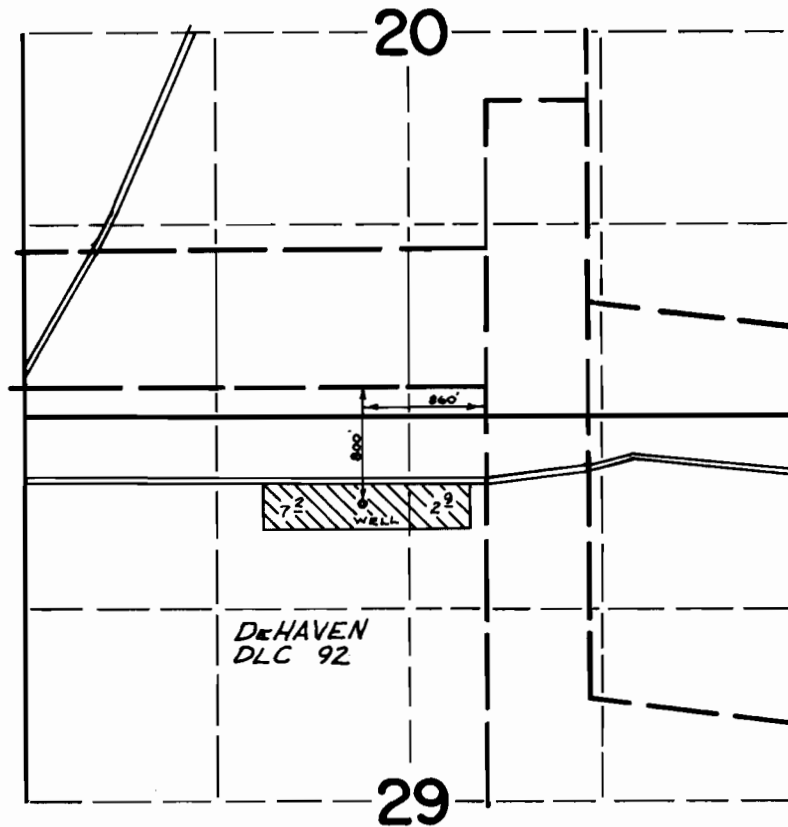

FINAL PROOF SURVEY UNDER

Application No. G-4612 Permit No. G-4336
IN NAME OF

G. W. STUHLIK

Surveyed SEPT 22 1972, by D. Norby