


T. 5 S. R. 2 W. W.M.

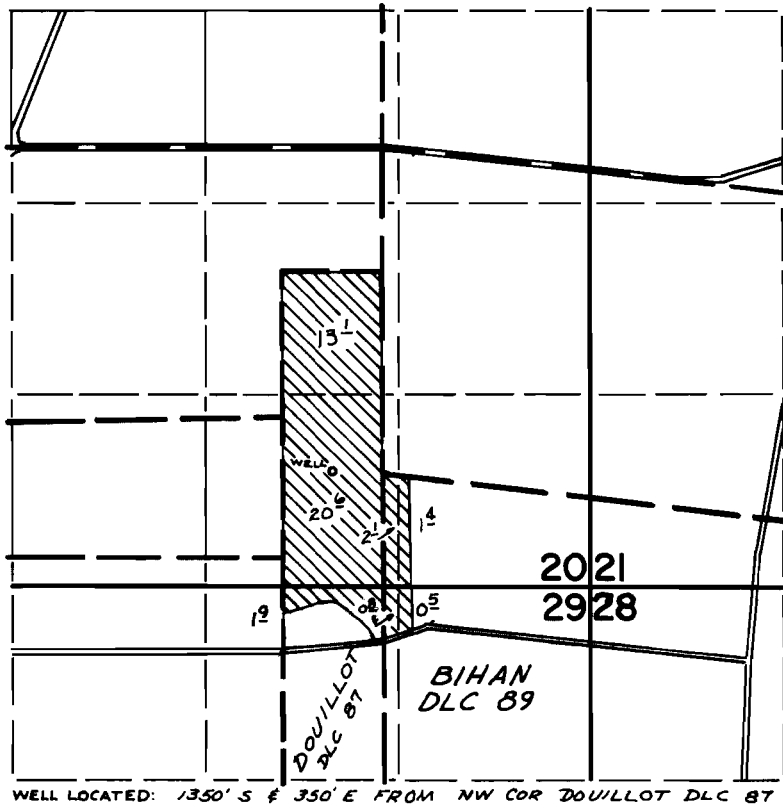

FINAL PROOF SURVEY UNDER

Application No. G-4665 Permit No. G-4389
IN NAME OF

MRS. J.E. BORDEN

Surveyed Sept 22 1972, by D. Norby