


T.6S. R.18&2W. W.M.

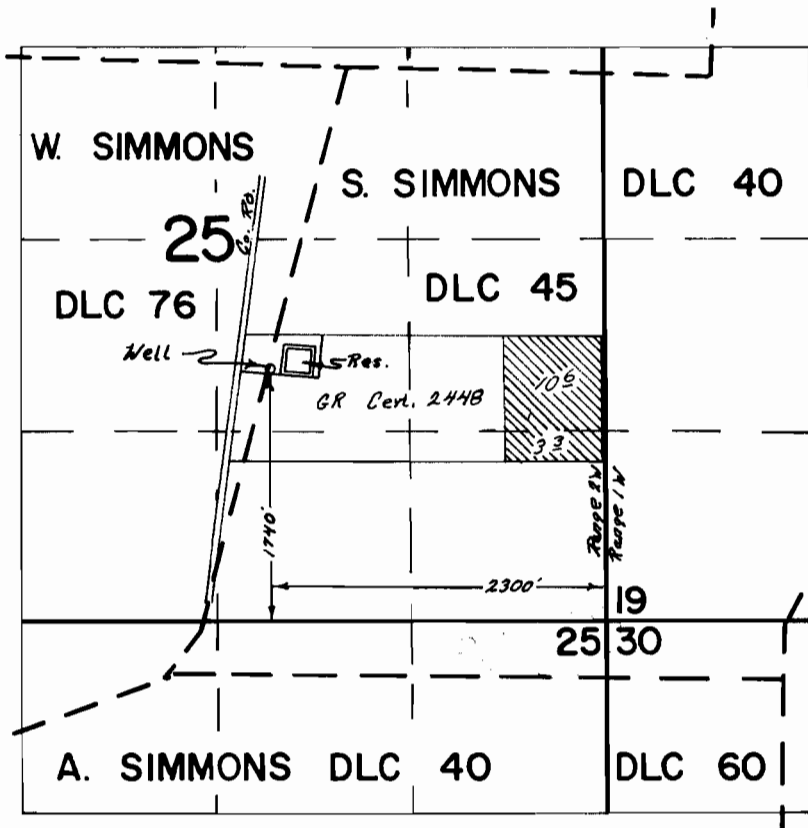

FINAL PROOF SURVEY
UNDER

Application No. G-4718 Permit No. G-4441
IN NAME OF

WAYNE LOVRE

Surveyed May 19 1922, by R. E. Mucken