


T.4S., R.2W., W.M.

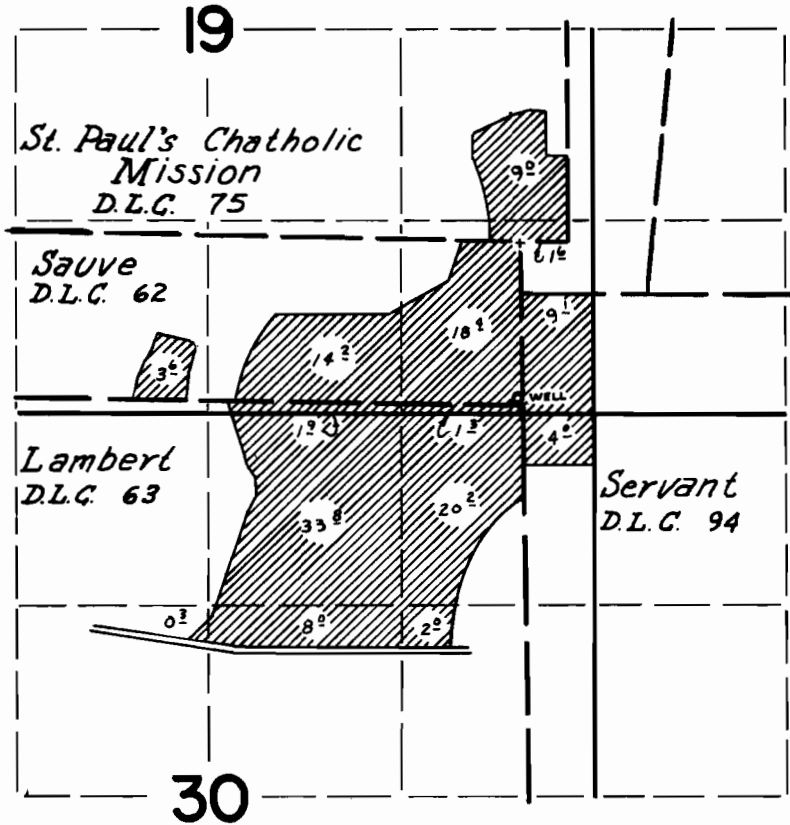

WELL LOCATED: 1070 ft. S. & 30 ft. W FROM NE COR. SAUVE D.L.C. 62.

FINAL PROOF SURVEY UNDER

Application No. G-4729 Permit No. G-4449
IN NAME OF

EDWARD T. BRENTANO

Surveyed Oct. 4 1972, by D. Norby