


T.10S. R.3W. W.M.

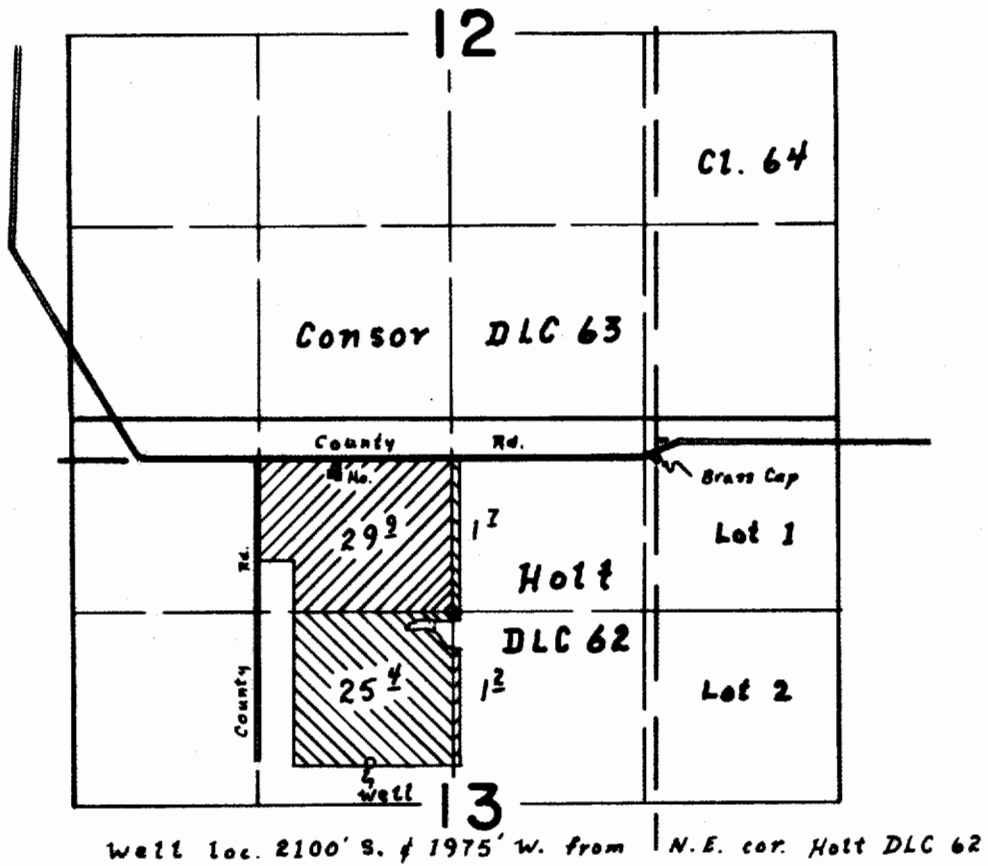

Well loc. 2100' S. of 1975' W. from N.E. cor. Holt DLC 62

**FINAL PROOF SURVEY**  
UNDER

Application No. G-4910 Permit No. G-4627  
IN NAME OF

E. W. Hart

Surveyed 18 OCT 1972, by A. O'Reilly