


# T.6S. R.1W. W.M.

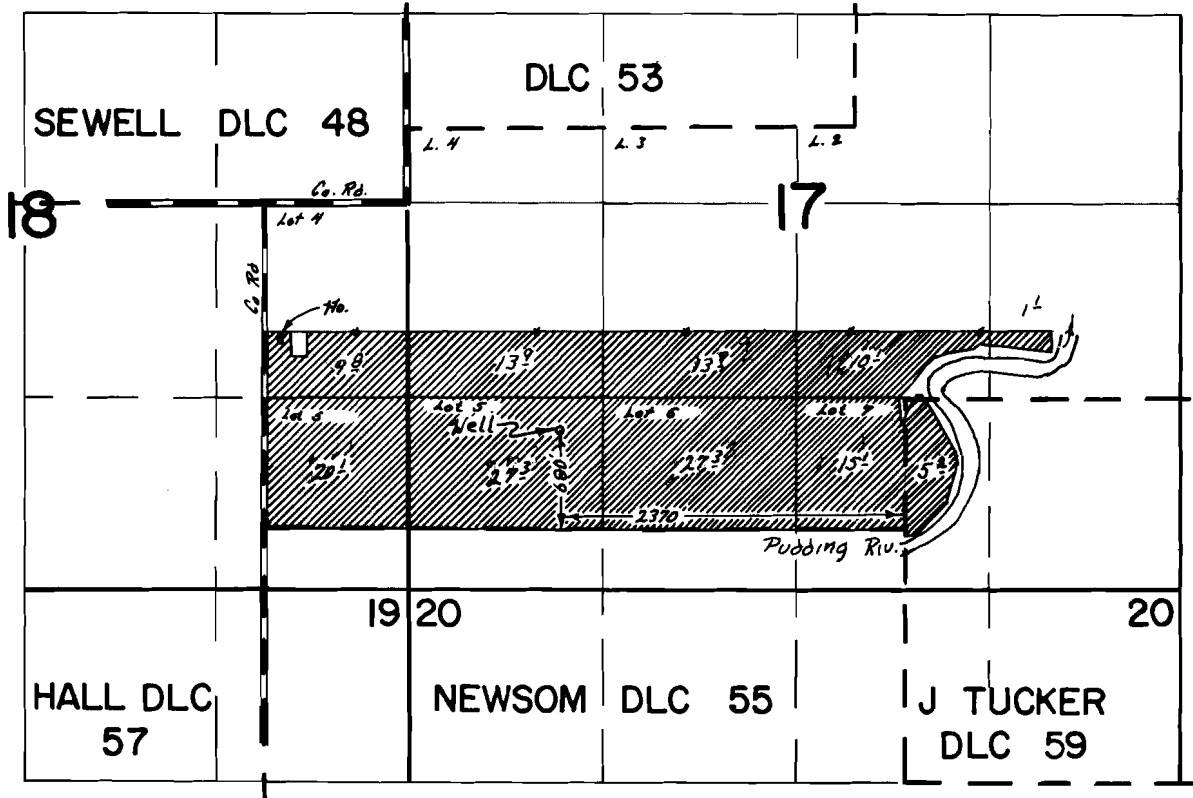

## FINAL PROOF SURVEY UNDER

Application No. C-5149 Permit No. B-4082  
IN NAME OF

FRANK H. JOHNSON

Surveyed June 1 1972, by R. B. Mucken