


T. 7 S. R. 1 W. W.M.

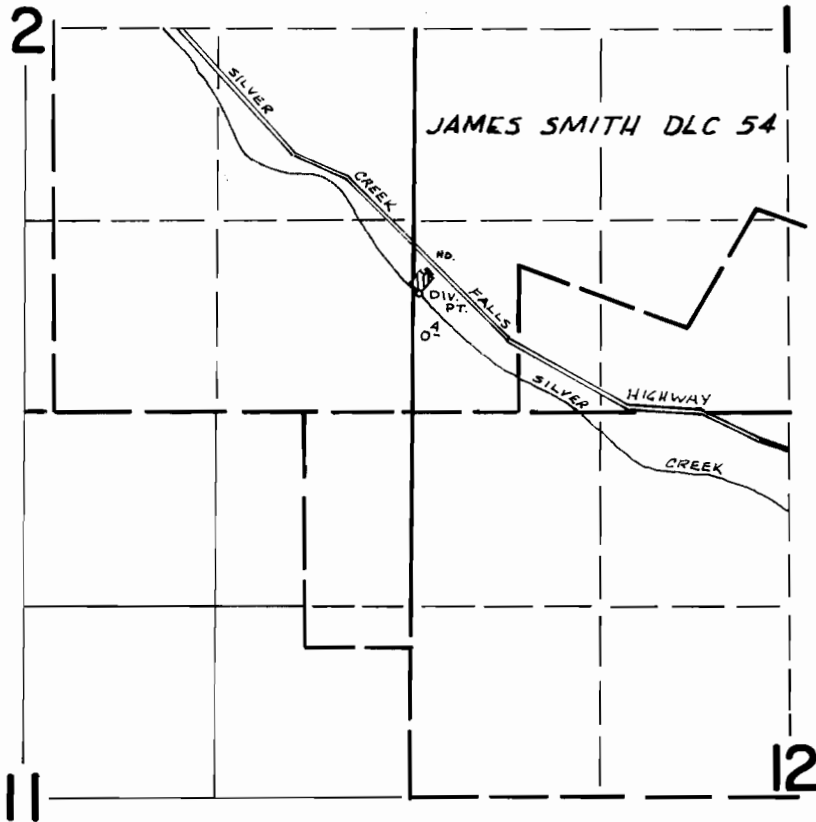

DIV. PT. LOCATED: 1820' S & 40' E FROM W $\frac{1}{4}$ COR SEC 1

FINAL PROOF SURVEY UNDER

Application No. 42458 Permit No. 31676
IN NAME OF

DANIEL M. HAAK

Surveyed APRIL 20 1972 by D. NORBY