


T.6S. R.1W. W.M.

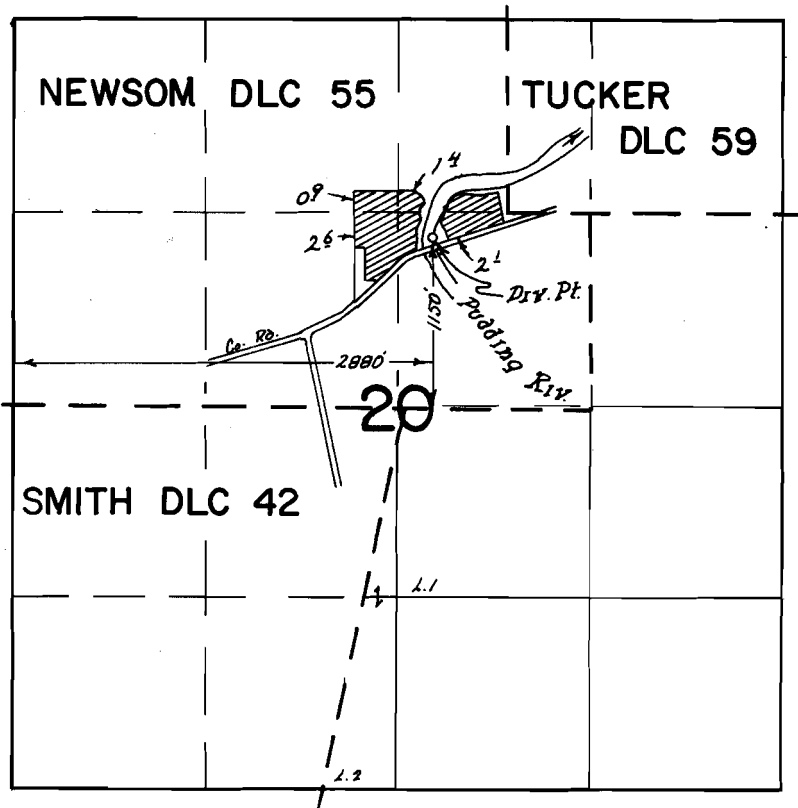

FINAL PROOF SURVEY UNDER

Application No. 44257 Permit No. 33138
IN NAME OF

HARLAN M. & DOROTHY V. BONES

Surveyed June 17 1972, by R. B. Mucken