


# T.6S. RIW. W.M.

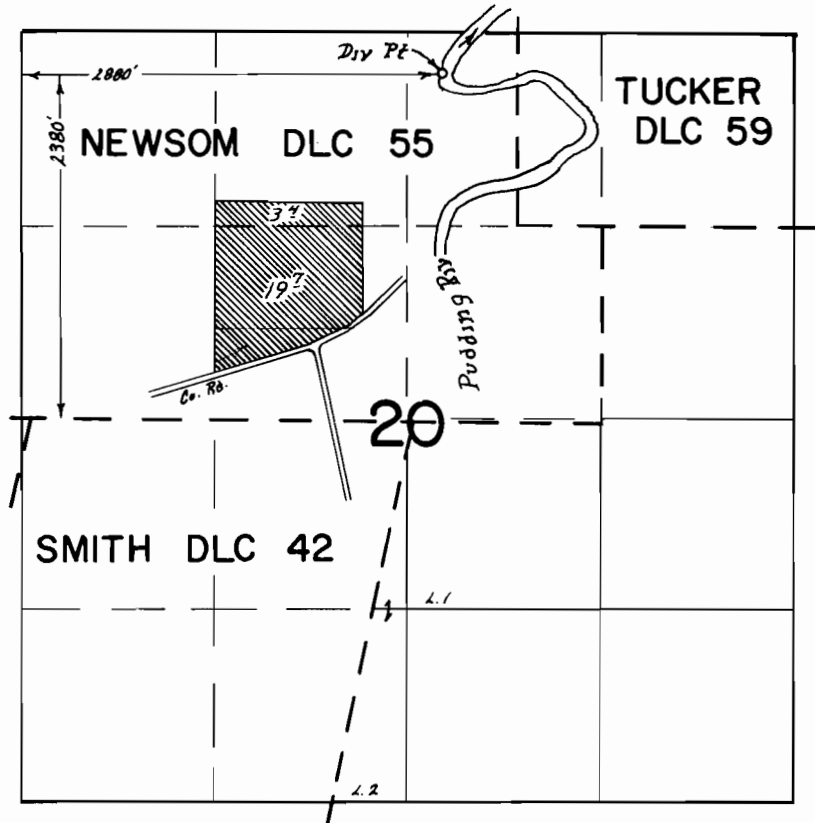

## FINAL PROOF SURVEY UNDER

Application No. 44727 Permit No. 33509  
IN NAME OF

ALAN OBERSINNER

Surveyed June 17 1972, by R. G. Mucken