


T. 7 S. R. 1 W. W.M.

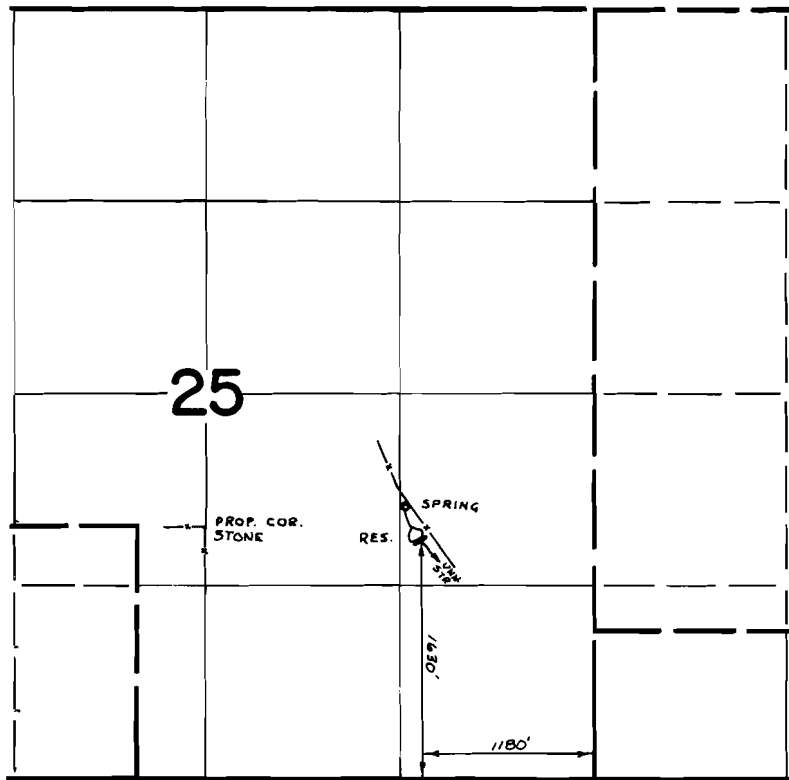

FINAL PROOF SURVEY
UNDER

Application No. ^{R-41366} ~~41367~~ Permit No. ^{R-4665} ~~30901~~
IN NAME OF

IVAN WAYNE GOODE

Surveyed APRIL 21 1972, by D. NORBY