


T.7&8S. R.IW. W.M.

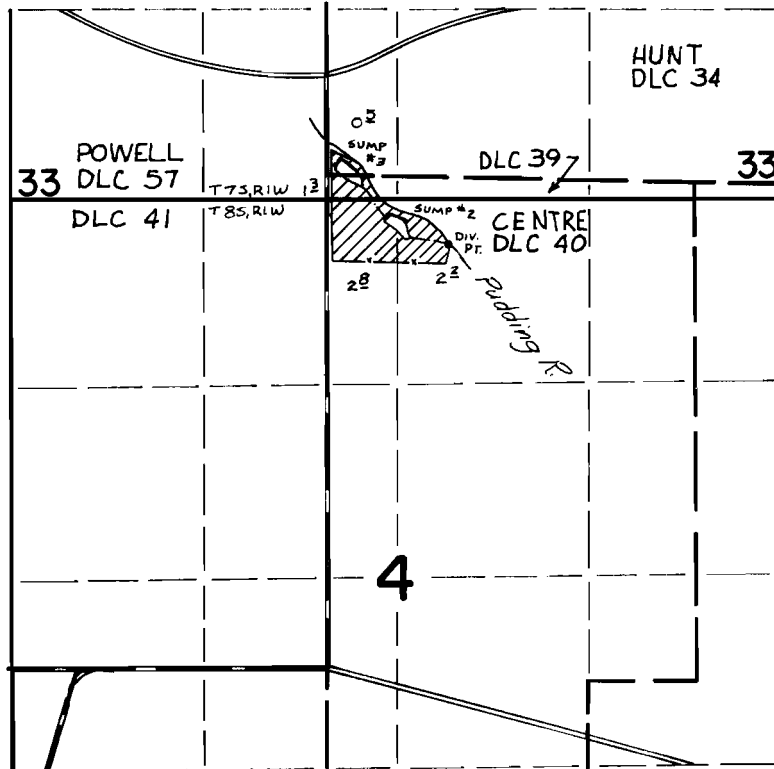

DIV. PT. LOCATED: 2920' N & 830' E FROM SE COR POWELL DLC 41
 DAM, SUMP #2 LOCATED: 3100' N & 400' E FROM SE COR POWELL DLC 41
 DAM, SUMP #3 LOCATED: 3500' N & 100' E FROM SE COR POWELL DLC 41

FINAL PROOF SURVEY UNDER

Application No. R-42475 42476 Permit No. R-4825 31766
 IN NAME OF

JAMES W. GILHAM

Surveyed April 25 1972 by D. Norby