


T. 4 S., R. 2 W., W.M.

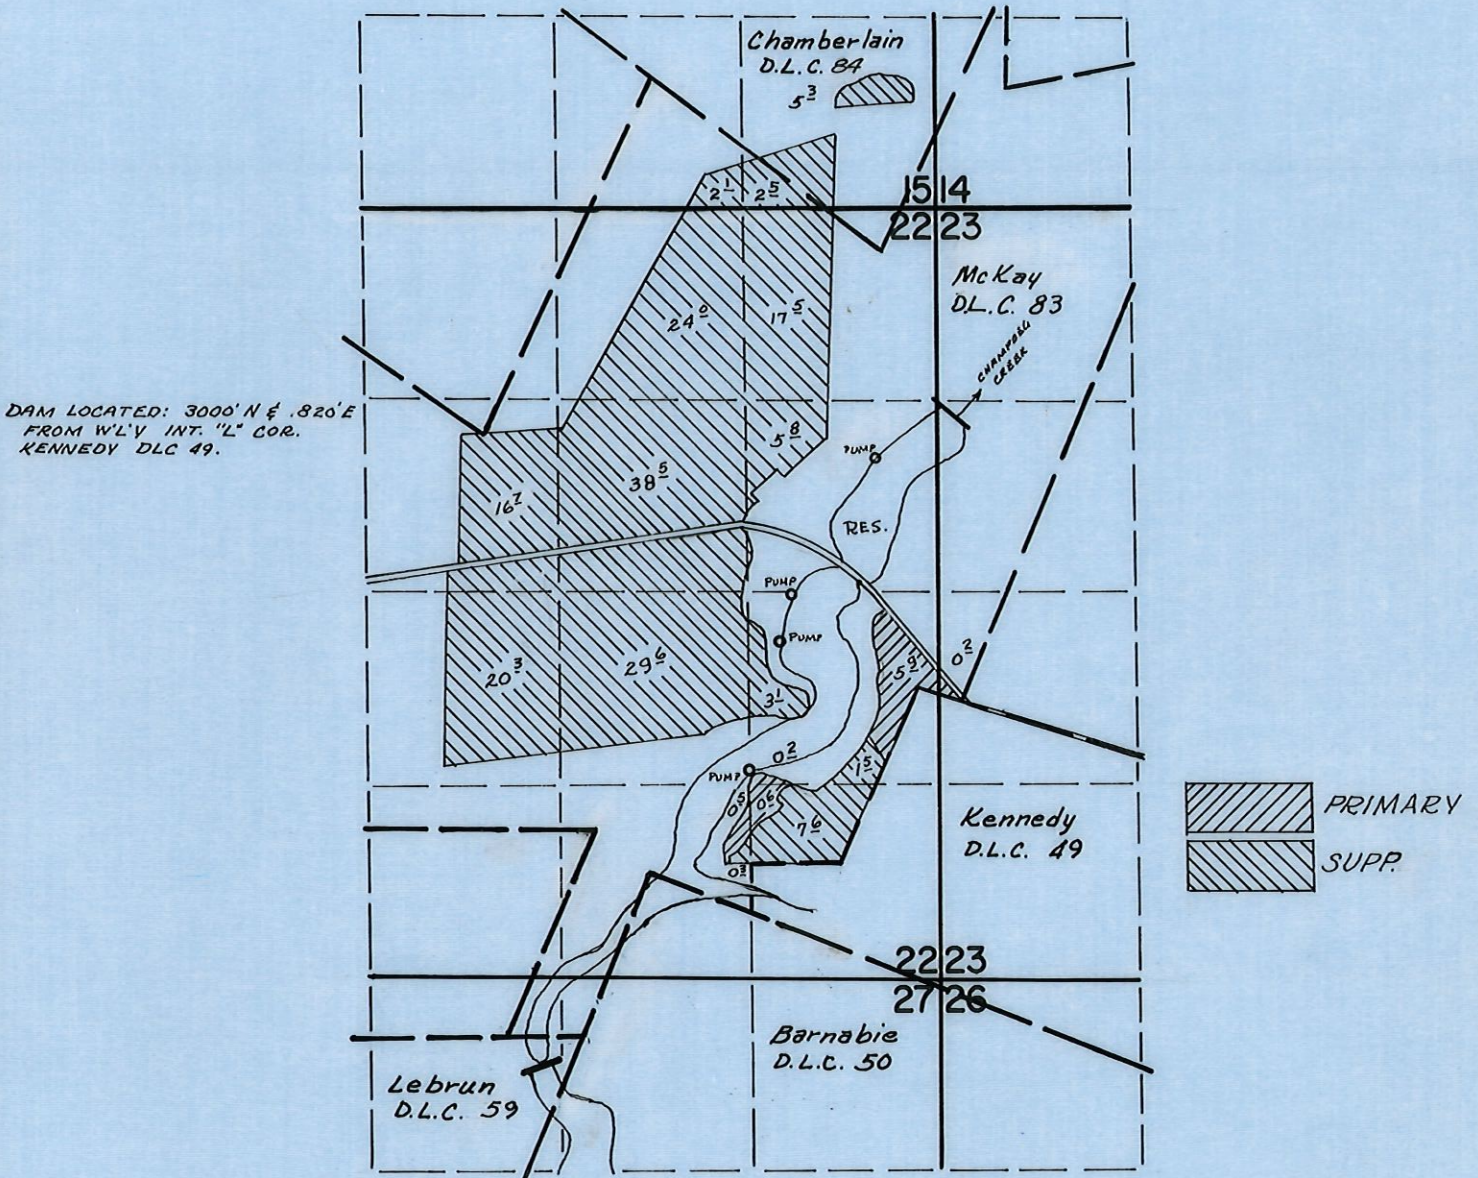

FINAL PROOF SURVEY UNDER

Application No. R-44070
44071 Permit No. R-4964
32366

IN NAME OF

A & R SPADA FARMS

Surveyed Oct. 4 1972, by D. Norby