


T.1S.R.38E.W.M.

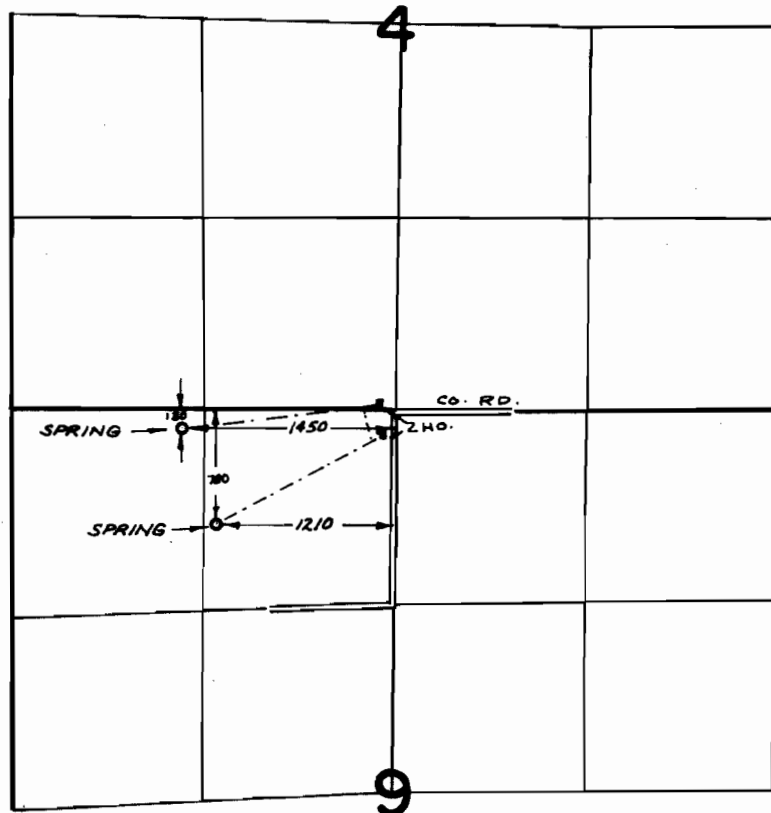

FINAL PROOF SURVEY
UNDER

Application No. 40292 Permit No. 36327
IN NAME OF

J.F. COLLUM & M.C. NORMAN

Surveyed JULY 12, 1973, by R. MUCKEN