


T.3S. R.45E. W.M.

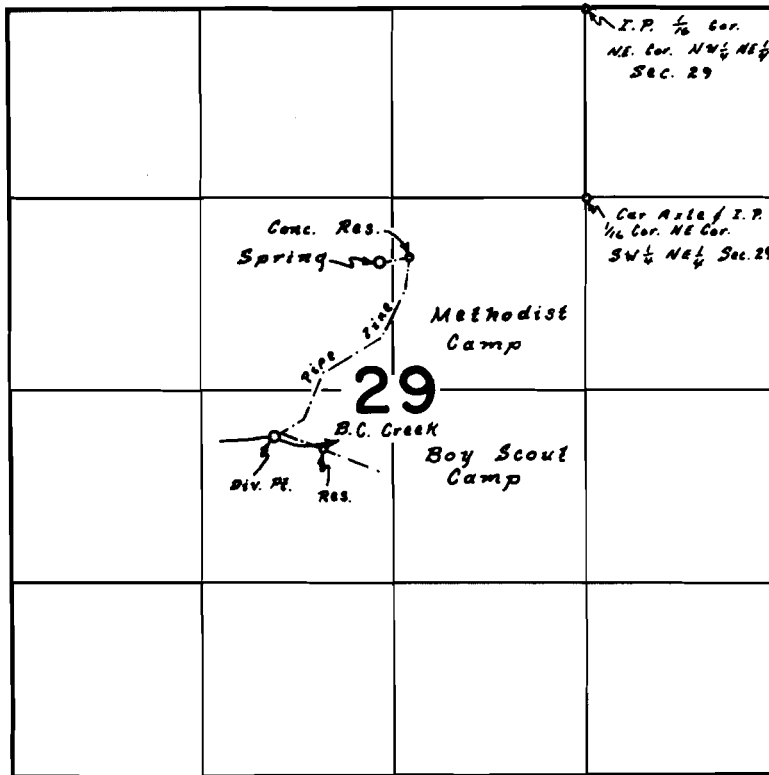

Diversion Points
Spring 450'S. x 1420'W. }
B.C. Creek 1650'S. x 2140'W. } All sec. from N.E. Cor. SW 1/4 NE 1/4 Sec. 29

FINAL PROOF SURVEY
UNDER

43995 32891

Application No. 43996 Permit No. 32892

IN NAME OF

Cecil Chrisman

Surveyed 22 June 1972, by L.E. Gould