


T.5S., R.4W., W.M.

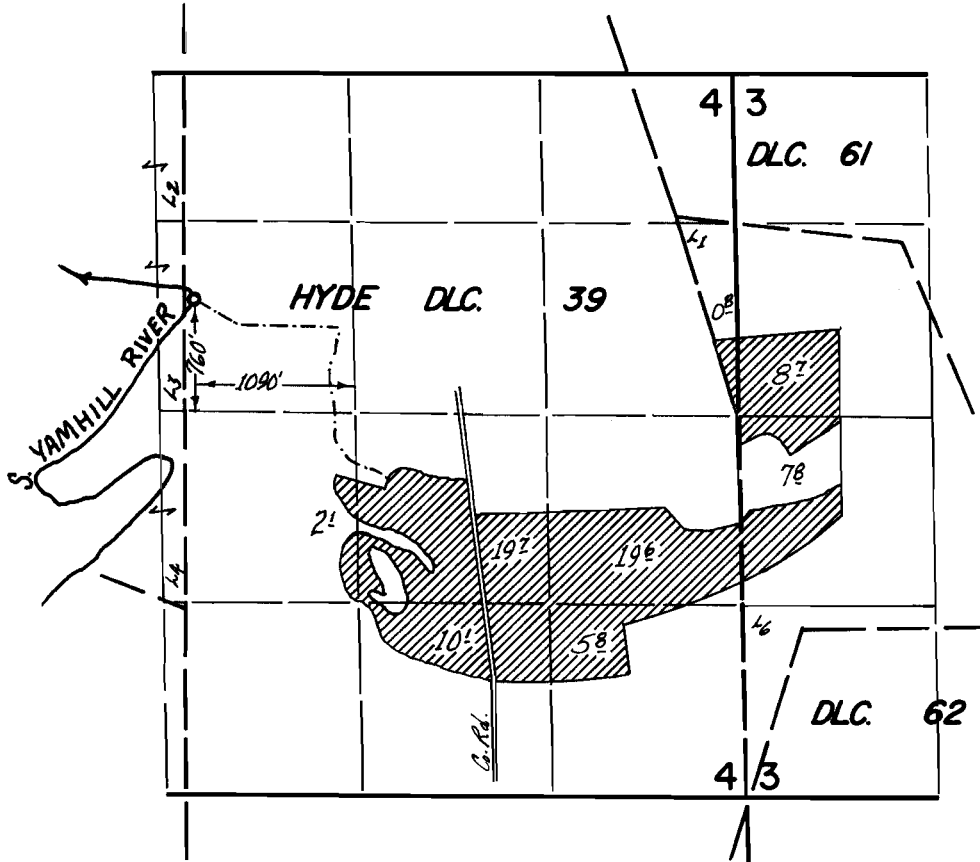

FINAL PROOF SURVEY
UNDER

Application No. 44183 Permit No. 33012
IN NAME OF

JAMES M. & ETHELYN BOESE

Surveyed 14 Nov. 19 72, by D. NORBY