


T.29S., R.14W., W.M.

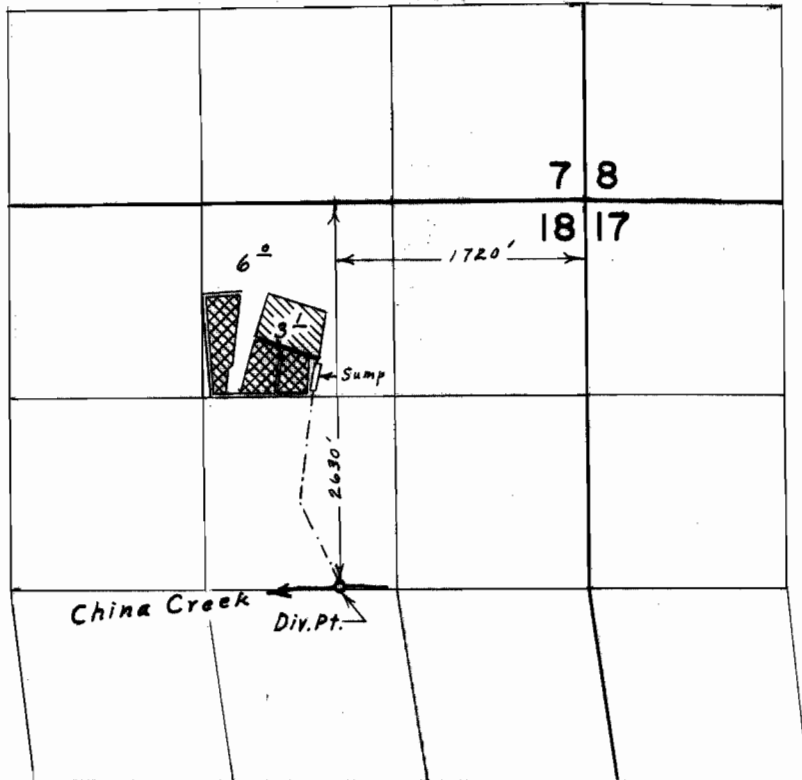

Primary  
Supplemental



**FINAL PROOF SURVEY**  
UNDER

Application No. 43743 Permit No. 32688  
IN NAME OF

JACK L. JONES

Surveyed April 21, 1972, by L. E. Gould