


T.28S. R.14W. W.M.

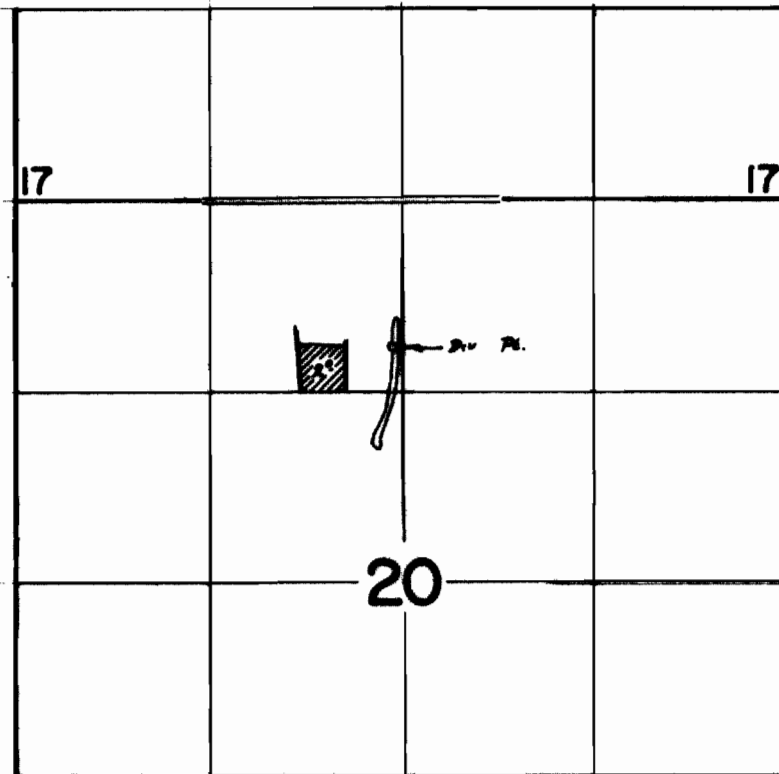

Well Loc 1000's + 50' W From N 1/4 Cor. Sec. 20

FINAL PROOF SURVEY
UNDER

Application No. 6-4224 Permit No. 6-465B
IN NAME OF

INGRAM BROTHERS, FLOYD & KENNETH INGRAM

Surveyed April 12, 1952, by J. E. Gould