


T.28S., R.11W., W.M.

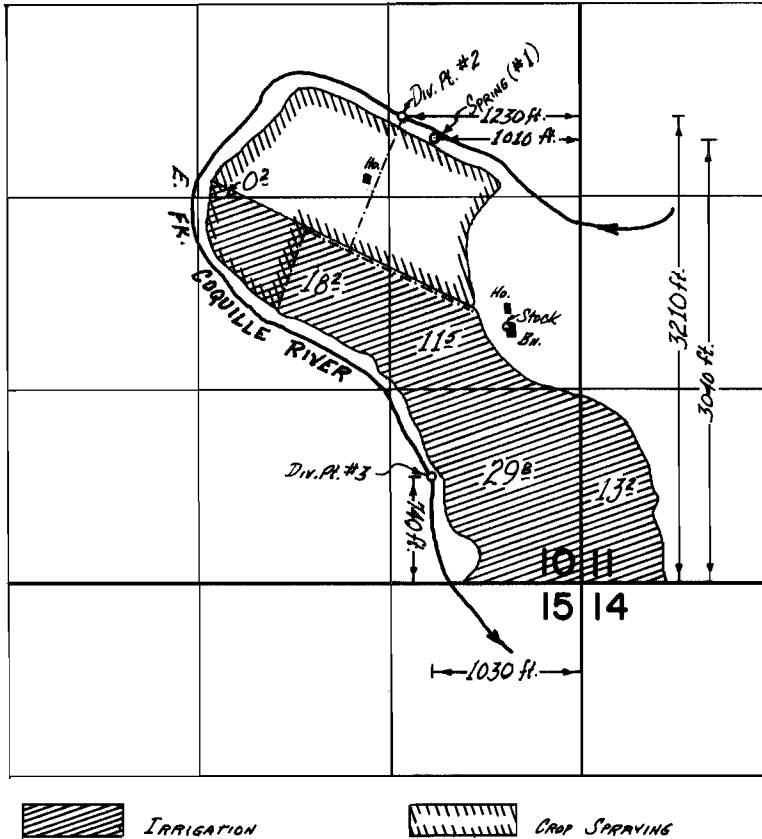

**FINAL PROOF SURVEY**  
UNDER

Application No. 39454 Permit No. 29296  
IN NAME OF

MURL LAIRD

Surveyed 15 JULY 19 72, by L.E. GOULD