


T.27S.R.2W.W.M.

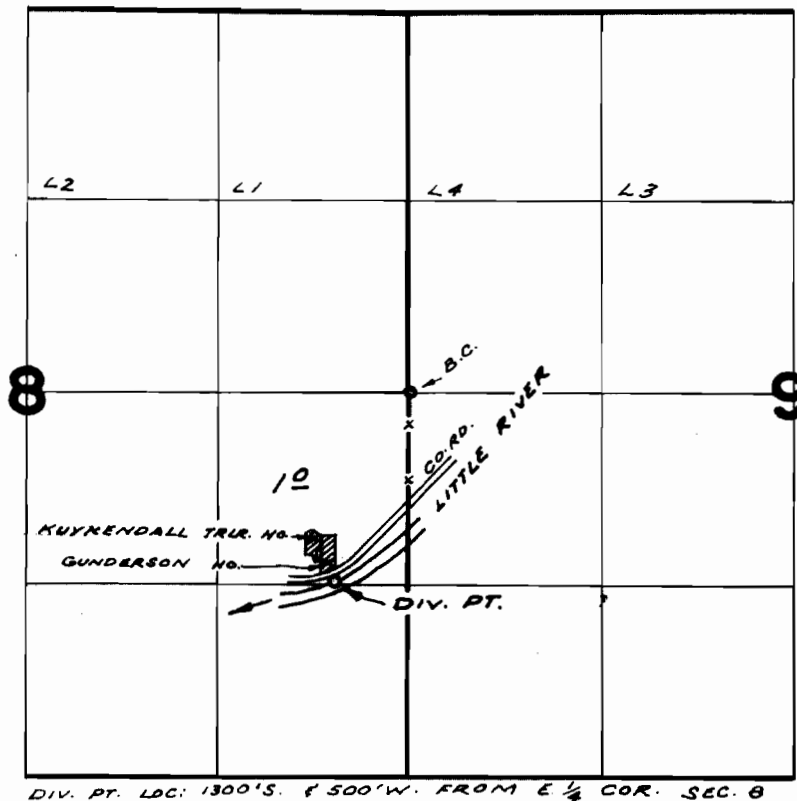

FINAL PROOF SURVEY UNDER

Application No. 43180 Permit No. 32282
IN NAME OF

CLARENCE GUNDERSON & GEORGE K. KUYKENDALL

Surveyed MAY 4, 1972, by R. MUCKEN