


T. 24 S., R. 5 W., W.M.

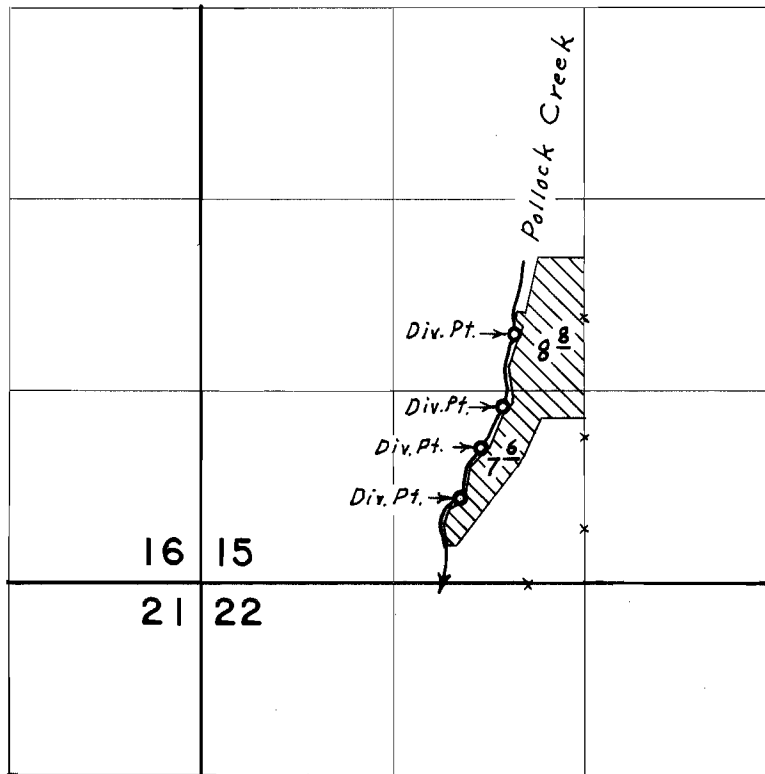

Div. Pts. located: 1710' N. & 480' W.; 1210' N. & 570' W.;
930' N. & 720' W.; 580' N. & 860' W.; all from S. $\frac{1}{4}$ Cor. Sec. 15

FINAL PROOF SURVEY
UNDER

Application No. 39397 Permit No. 29365
IN NAME OF
PAUL J. FROST

Surveyed May 9, 1972, by L. E. Gould