


T. 22 S. R. 13 W. W. M.

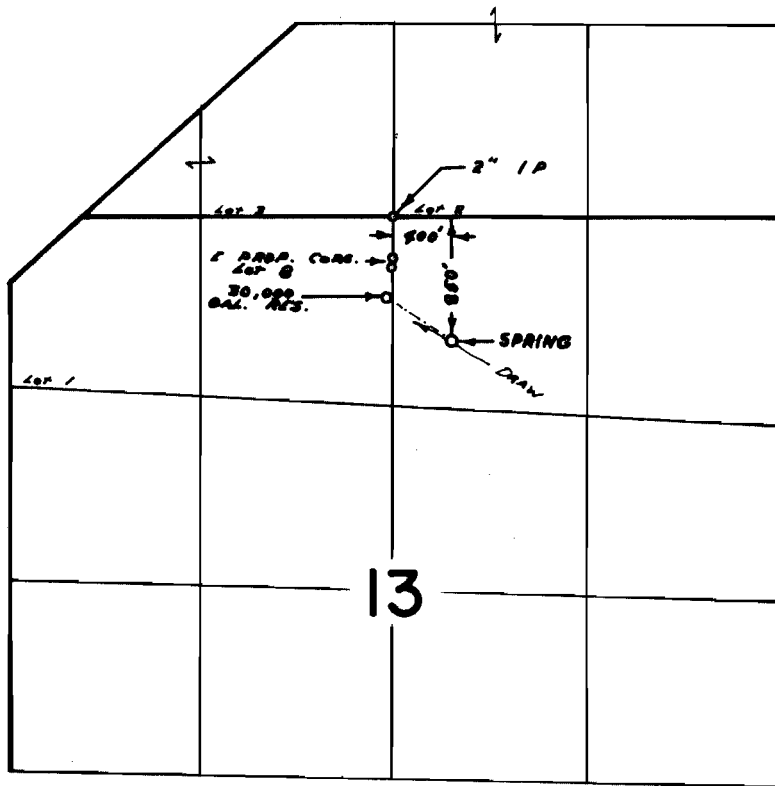

FINAL PROOF SURVEY
UNDER

Application No. 41525... Permit No. 30967..
IN NAME OF

.....JOHN ZIOLKOWSKI.....

Surveyed AUG. 8., 1971., by R. G. MUCKEN.