


T.30S.R.5 W.W.M.

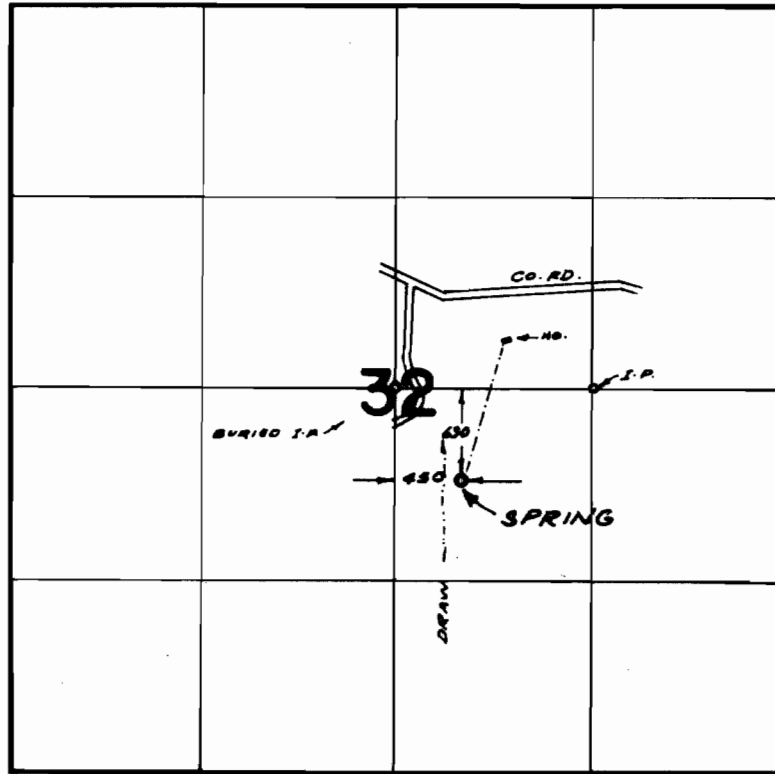

FINAL PROOF SURVEY UNDER

Application No. 42031 Permit No. 32012
IN NAME OF

JAMES A. FULLER

Surveyed MAY 12, 1972, by R. MUCKEN