


T.26S., R.7W., W.M.

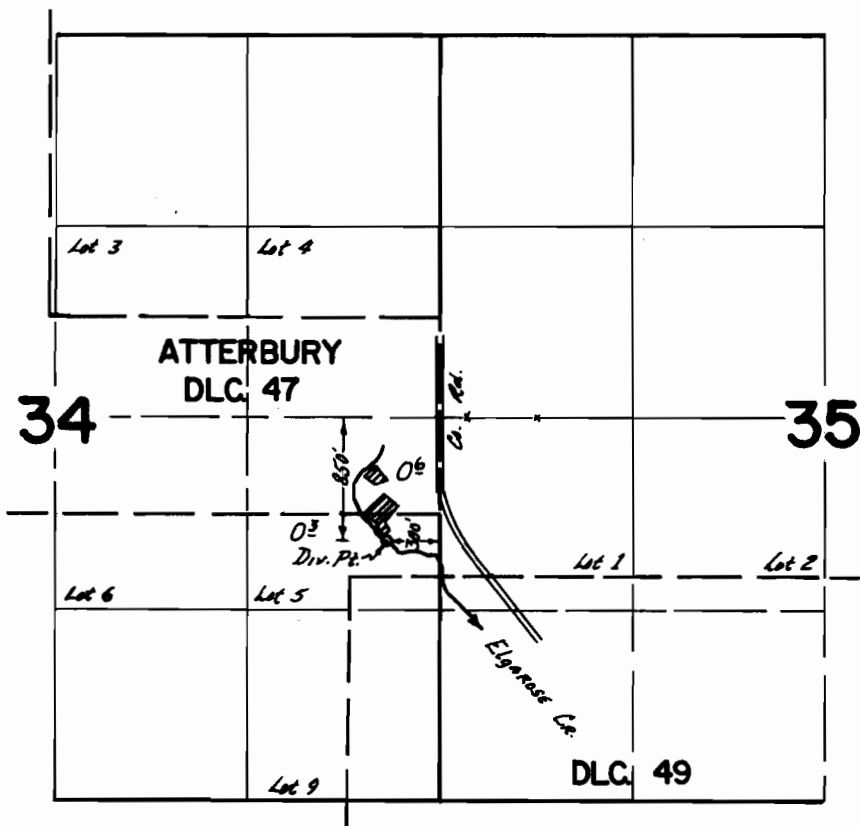

FINAL PROOF SURVEY
UNDER

Application No. 43292 Permit No. 32242
IN NAME OF

RAYMOND A. & SUZANNE H. ANDERSON

Surveyed 5 May 1972, by D. NORBY