


T.26 & 27S. R.3W.W.M.

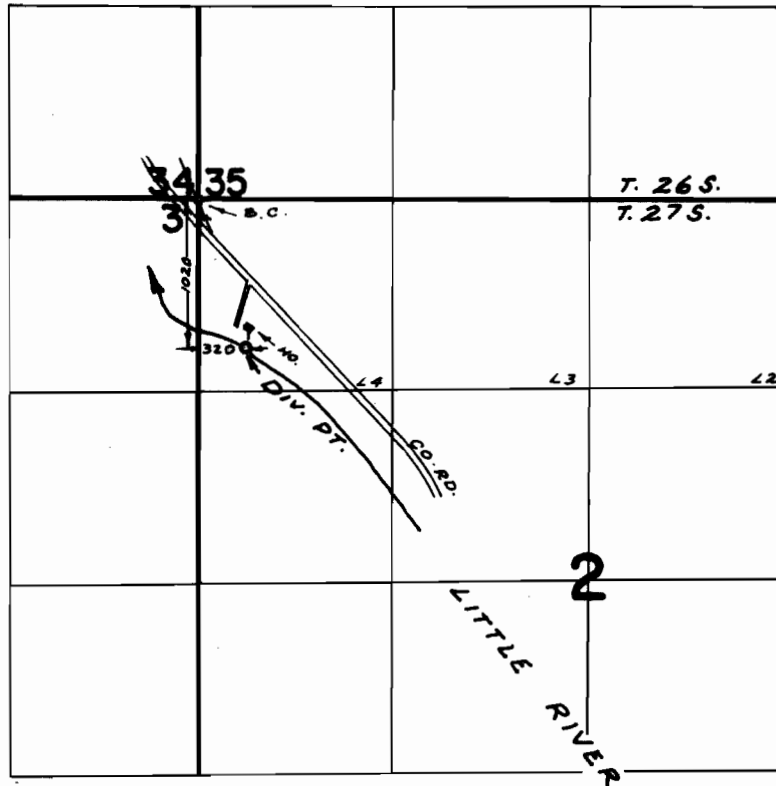

**FINAL PROOF SURVEY**  
UNDER

Application No. 43299 Permit No. 32379  
IN NAME OF

ROY ALLEN HANSEN

Surveyed MAY 5, 1972, by R. MUCKEN