


T.29S., R.8W., W.M.

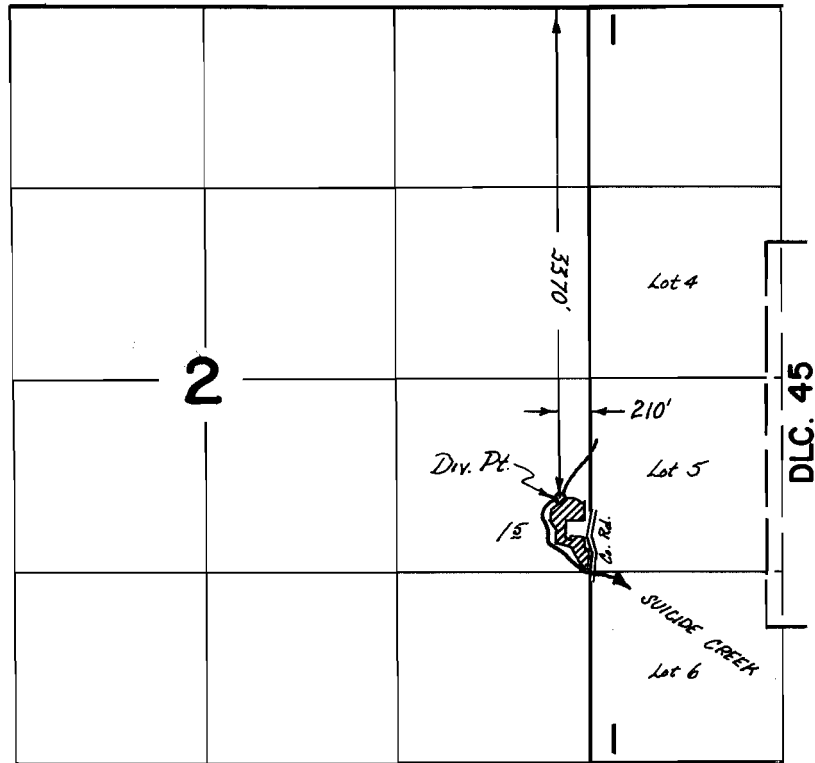

FINAL PROOF SURVEY
UNDER

Application No. 43635 Permit No. 32623
IN NAME OF

RICHARD L. CROSS

Surveyed 9 May 1972, by D. NORBY