


T.22S., R.5W., W.M.

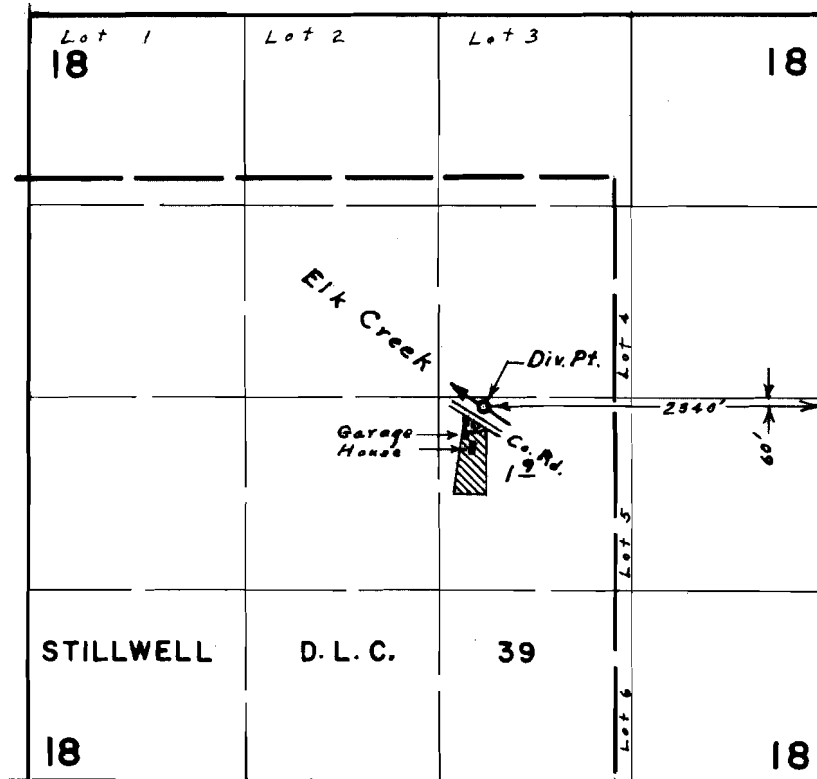

FINAL PROOF SURVEY
UNDER

Application No. 44109 Permit No. 32948
IN NAME OF

LEONARD C. & JANE K. HARMS

Surveyed May 4, 1972, by L. E. Gould